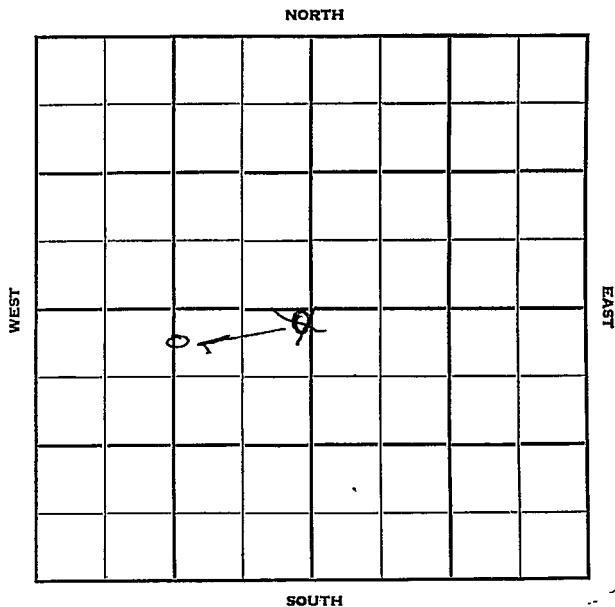


Finney KANSAS

Section 5 Township 22 Range 34 WWell No. # 1 McDanielsCompany Kansas-Nebraska

Finney

KANSAS

Sec. 5 Twp. 22 R. 34WWell No. #1 McDaniels FarmKansas-Nebraska Company

Contractor


Hugoton Pool

~~330~~
~~100~~ Ft. from N. Line

Ft. from S. Line

~~1320~~
~~100~~ Ft. from E. Line~~1320~~ Ft. from W. Line~~NE SW~~

C N/2 N/2 SW

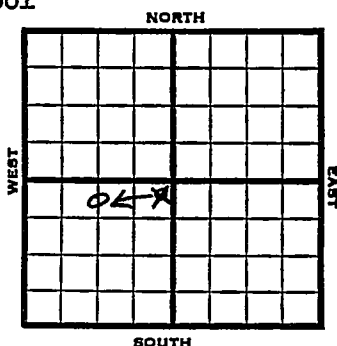

1953

Elev. 2990'

REPORT

6/24

Spud 6-10-53

10" @ 300'

TD 2659'

7" @ 2655'

WOC

7/1

Her Kr 2572 Win 2632

168/2572-2600 102/2632-49

6000 dol.

10/7

Spud 6-10-53 Gas well TD 2659

10" @ 300 TD 2659 7" @ 2655

Her. 2572 Win. 2632'

168/2572-2600 102/2633-49

6000 dol-frac.

Comp. 4 MCFGPD

COMPLETED

J. G. McGEHEE

Map No. _____ Sec. 5 Twp. 22 R. 34WWell No. 1 McDanielsKansas - Nebraska Company

Contractor


C N/2 N/2 SW

SECTION PLAT

330 Ft. from N. Line

_____ Ft. from S. Line

_____ Ft. from E. Line

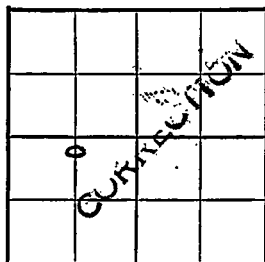1320 Ft. from W. Line

Location _____

Rig up _____

Drilling and Remarks:

Reported
NE NE SW

RECORD

Cased _____ in., _____ ft.

Sand _____

Gas _____

Oil _____

Total Depth _____

PRODUCTION

1st 24 hrs. Nat. _____

1st 24 hrs. after shot _____

Gas _____ Cu. Ft.

Dry Hole _____

Abandoned _____

Date

JUL 8 1953

J. G. McGEHEE

19

Scout


Kansas

Map No. _____ Sec. 5 Twp. 22 R. 34WWell No. 1 McDaniels

_____ Kansas-Nebraska _____ Company

CORRECTION _____ ContractorC $N\frac{1}{2}$ $N\frac{1}{2}$ SW

SECTION PLAT

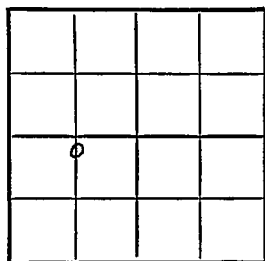330 Ft. from N. Line

_____ Ft. from S. Line

1320 Ft. from E. Line

_____ Ft. from W. Line

Finney County

Location _____

Rig up _____

Drilling and Remarks:

Reported

NE SW

RECORD

Cased _____ in., _____ ft.

Sand _____

Gas _____

Oil _____

Total Depth _____

PRODUCTION

1st 24 hrs. Nat. _____

1st 24 hrs. after shot _____

Gas _____ Cu. Ft.

Dry Hole _____

Abandoned _____


Date

OCT 7 1953

19

J. G. McGEHEE Scout

County Finney State Kansas
 Sec. 5 (Blk.) 22 (Sur.) 3 4W Map No.
 Operator Kansas-Nebraska
 Well No. 1 Farm McDaniels
 Elev. 2990 Location CIN $\frac{1}{2}$ N $\frac{1}{2}$ SW

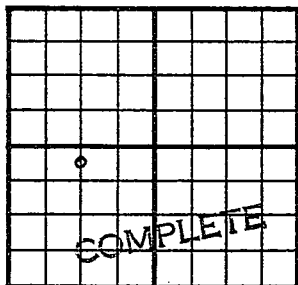

300 Ft. From N Line SW
1320 Ft. From E Line Quarter

1st. Report

Completion OCT 7 1953

Remarks Hugoton Pool

Spudding Date 6-10-53

Drlg. Data Gas well TD 2659

10" @ 300 TD 2659 7" @ 2655

Her. 2572 Win. 2632 168/ 2572-2600

102/ 2633-49 6000 dol-frac

Comp. 4 mcf/gpd