

KANSAS

Stafford

FORM 51 5M 10-41 PETROL

Section 6 Township 22 Range 13-W

Well No. #1 Curtis


Company Vickers

Miscellaneous

NORTH

WEST

EAST

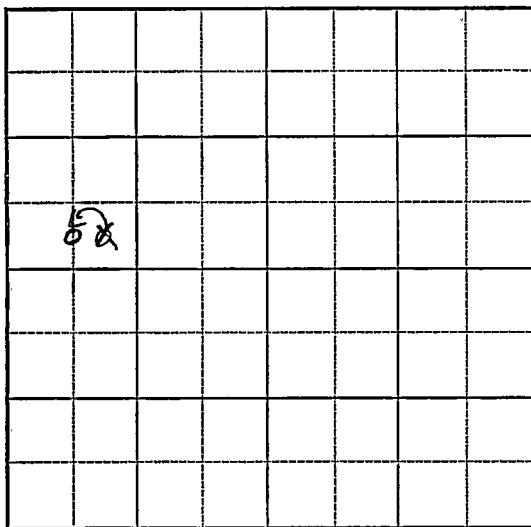

SOUTH

O.W.W.O.

KANSAS


Stafford

Sec. 6 Twp. 22 R. 13WWell No. 1-Curtis FarmVickers Company

(Miscellaneous)

 Ft. from N. Line330 Ft. from S. Line Ft. from E. Line660
~~880~~ Ft. from W. Line

Elev. 1913

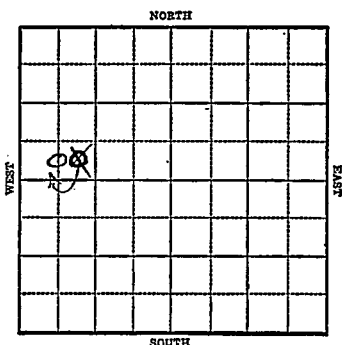

1942

R E P O R T

9/30 Rotary tools
10/7 Drlg. 1690
10/14 Lans. 3366
SO 3401-05, 3453-64
Drlg. 3505'
10/21 BKC 3607 Cong 3620
Viola 3629 SO 3629-40. Simp 3646
5" @ 3693 Rust
10/28 8250' oil in 3 hrs 30.6 gravity
11/11 5" @ 3693
Arb. 3693
T.D. 3700'
Depth to Pot. 138465
1000 gals. acid
Max 3000
Gravity 29.5

1950
7/19**COMPLETED**
O.W.W.O.Lans 3366
5" @ 3693
OTD 3700

Arb 3693

SP 3582
12/3495-3505
12/3514-24**OVER**

1950 (information brought forward)
7/19 FU 2900' fluid 1 1/4 hr
S/15 boph 1/4 hr
Comp 117 bopd 62% wtr
Completed

FIRST REPORT

COMPLETED

Stafford

KANSAS


Map No. 82 Sec. 6 Twp. 22 R. 13WWell No. 1 CurtisVickers

Company

Contractor

SE SW NW

SECTION PLAT

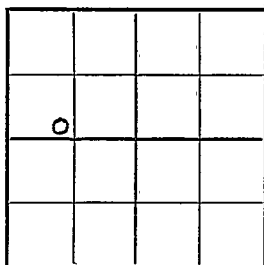 Ft. from N. Line330 Ft. from S. Line Ft. from E. Line990 Ft. from W. Line

MISCELLANEOUS

Location Rig up

Drilling and Remarks:

Rotary Tools

RECORD

Cased in., ft.Sand Gas Oil Total Depth

PRODUCTION

1st 24 hrs. Nat. 1st 24 hrs. after shot Gas Cu. Ft.Dry Hole Abandoned

Date

FIRST REPORTS

S. J. LEWIS

SEP 30 1942 19

Scout

Misc. Small Maps
Cards
Tracing
France Map
Scarborough Map
Moody Map
Geological Dept.
Moody Flat Book

Stafford

KANSAS

Map No. 82 Sec. 6 Twp. 22 R. 13WWell No. 1 CurtisVickers Petroleum CompanyCORRECTION Contractor

C SL SW NW

SECTION PLAT

o			

Ft. from N. Line330 Ft. from S. LineFt. from E. Line660 Ft. from W. Line

WILDCAT

Location _____

Rig up _____

Drilling and Remarks:

Reported

SE SW NW

RECORD

Cased _____ in., _____ ft.

Sand _____

Gas _____

Oil _____

Total Depth _____

PRODUCTION

1st 24 hrs. Nat. _____

1st 24 hrs. after shot _____

Gas _____ Cu. Ft.

Dry Hole _____

Abandoned _____

Date

OCT 14 1942 19S. J. LEWIS Scout

10. 1. 3

10. 1. 3

10. 1. 3



Handwritten signature/initials

Misc. Small Maps

Cards

Tracing

France Map

Scarborough Map

Moody Map

Geological Dept.

Moody Plat Book

KANSAS


Stafford

Map No. 82 Sec. 6 Twp. 22 R. 13WWell No. 1 CurtisVickers Petroleum Company**COMPLETED**

Contractor

C SL SW NW

SECTION PLAT

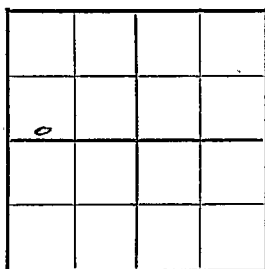 Ft. from N. Line330 Ft. from S. Line Ft. from E. Line660 Ft. from W. Line

WILDCAT

Location Rig up

Drilling and Remarks:

CR 36935" 36931000 cuilDepth 137465Max 3000295 gr

RECORD

Cased in., ft.Sand Gas Oil Total Depth 3700

PRODUCTION

1st 24 hrs. Nat. 1st 24 hrs. after shot Gas Cu. Ft.Dry Hole Abandoned

Date

NOV 11 194219S. J. LEWISScout

Misc. Small Maps *One*

Cards *Box*

Tracing *MBS*

France Map *✓*

Scarborough Map *✓*

Moody Map *✓*

Geological Dept. _____

Moody Plat Book _____

Map No. _____ Sec. 6 Twp. 22 R. 13WWell No. 1 Curtis "A" O.W.W.O.Vickers Pet._____
Company_____
Contractor

C S L SW NW

El. 1913

SECTION PLAT

o			

FIRST REPORT
COMPLETE_____
Ft. from N. Line330 Ft. from S. Line_____
Ft. from E. Line660 Ft. from W. Line

Stafford County

Location _____

Rig up _____

Drilling and Remarks:

Lans. 3366

Arb. 3693

5" @ 3693

OTD 3700

SP 3582

12/ 3495-3505

12/ 3514-24

RECORD

Cased _____ in., _____ ft.

Sand _____

Gas _____

Oil _____

Total Depth _____

PRODUCTION

1st 24 hrs. Nat. _____

1st 24 hrs. after shot _____

Gas _____ Cu. Ft.

Dry Hole _____

Abandoned _____

Date

JUL 19 1950

19

Scout

JUL 25 1950

Scout Cards	70
Land Small Map	
Land Wall Map	3
Tracings	
France Map	
Pierce Map	
Misc.	

EU 2900+ fluid 14 hr.
S/ 15 bopn 4 hr.
Comp. 117 bopn 62% water