


Stafford

FORM 51 5M 1-42 PETROL

Section 6 Township 22 Range 13-W

Well No. #2 Curtis

Company Vickers etal

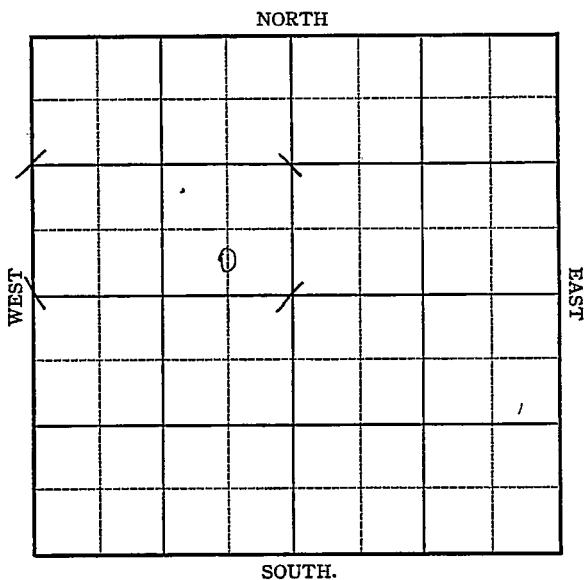

KANSAS

Stafford

Sec. 6 Twp. 22 R. 13-W

Well No. #2 Curtis Farm

Vickers etal. Company


Curtis

 Ft. from N. Line

330 Ft. from S. Line

660 Ft. from E. Line

 Ft. from W. Line

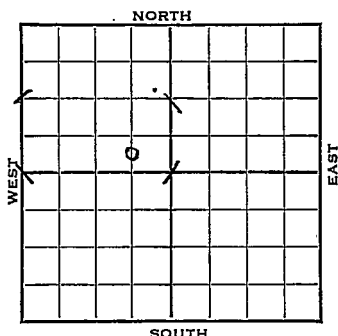

Elev. 1914

1943

REPORT

3/3

Surface hole

3/10

" "

3/17

10" Casing set 334
Drlg. 2900'

3/24

Lans. 3421
Congl. 3700
Viola 3711
T.D. 3720'
No shows.

ABANDONED

KANSAS, Stafford
 Map No. 82 Sec. 6 Twp. 22 R. 13W

Well No. 2 Curtis

Vickers et al. Company

FIRST REPORT Contractor

C SL SE NW


 Ft. from N. Line

330 Ft. from S. Line

660 Ft. from E. Line

 Ft. from W. Line

SECTION PLAT

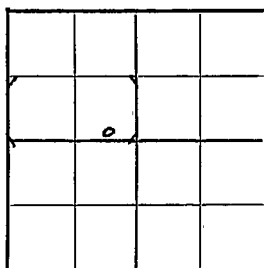

CURTIS POOL

Location

Rig up

Drilling and Remarks:

Surface Hole

RECORD

Cased in., ft.

Sand

Gas

Oil

Total Depth

PRODUCTION

1st 24 hrs. Nat.

1st 24 hrs. after shot

Gas Cu. Ft.

Dry Hole

Abandoned

Date

MAR 3 1941 19 S. J. LEWIS Scout


KANSAS

Stafford

Map No. 82 Sec. 6 Twp. 22 R. 13WWell No. 2 CurtisVicker et al. CompanyABANDONED Contractor

C SL SE NW

SECTION PLAT

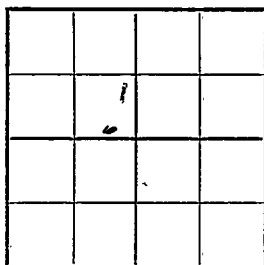 Ft. from N. Line330 Ft. from S. Line660 Ft. from E. Line Ft. from W. Line

CURTIS POOL

Location Rig up

Drilling and Remarks:


RECORD

Cased in., ft.Sand Gas Oil Total Depth 3720

PRODUCTION

1st 24 hrs. Nat. 1st 24 hrs. after shot Gas Cu. Ft.Dry Hole Abandoned

Date

MAR 24 1943 19 S. J. LEWIS Scout