

Stafford

FORM 51

KANSAS

Section 6 Township 22 Range 13W

Well No. #4 Curtis

Company Vickers Pet.

NORTH

0							

WEST

EAST

SOUTH

Stafford

KANSAS

SEC.	TWP.	R.
6	22	13W ✓

WELL NO.

#4 Curtis

FARM

COMPANY

Vickers Pet.

CONTRACTOR

Jayhawk Drlg.


Curtis Pool

_____ Ft. from N. Line

1040 _____ Ft. from S. Line

_____ Ft. from E. Line

330 _____ Ft. from W. Line

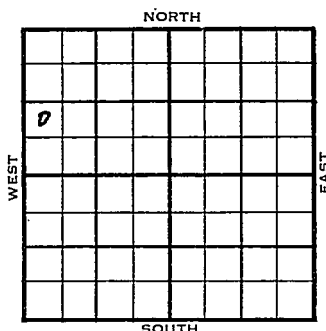

NW SW NW

	ELEVATION	REPORT
1954	1917'	
2/24	Spud 2-16-54 8" @ 340' Drlg 2875'	
3/3	Heeb 3241', Tor 3261', Doug 3273', Br li 3365', Lans 3377' RTD 3615' Schl 5" @ 3615'	
3/10	CO 3595' 42/3498-3512', 5 goph 1000A S/7½ boph, POP	
3/17	NR	
3/24	"	
4/7	Spud 2-16-54 Oil Well TD 3615' 8" @ 340' Heeb 3241', Tor 3261', Doug 3273' Br. Lime 3365', Lans 3377', TD 3615' 5" @ 3615' CO to 3595' 42/ 3498'-3512' SO & G 5 goph 1000 A S/ 7½ boph P/ 4 boph Comp & 71 bopd	

County Stafford State KansasSec. 6 (Blk. Twp.) 22 (Sur. Rge.) 13W Map No.Operator Vickers Pet.Well No. 4 Farm CurtisElev. Location NW SW NW

0							

FIRST REPORT

1040 Ft. From S Line NW330 Ft. From W Line Quarter1st. Report FEB 24 1954

Completion

Remarks

Jayhawk Drlg. - Contr.Spudding Date 2-16-54Drlg. Data Curtis Pool8" @ 340 drlg. 2875

J. G. McGEHEE

County Stafford State KansasSec. 6 (Blk.) 22 (Sur. Rge.) 13W Map No.Operator Vickers Pet.Well No. 4 Farm CurtisElev. 1917 Location NW SW NW

0							

1040Ft. From S Line NW330Ft. From W Line Quarter

1st. Report

Completion APR 7 1954Remarks Curtis PoolJayhawk Drlg. -Contr.Spudding Date 2-16-54Drlg. Data Oil well TD 36158" @ 340 Heeb. 3241 Tor. 3261Doug. 3273 Br. lime 3365 Lans. 3377TD 3615 5" @ 3615 CO to 359542/ 3498-3512 SO & G 5 goph 1000@S/ 7½ boph P/ 4 boph Comp. 71 bopd