


Section 6 Township 22 Range 13W

Well No. #3 Curtis "B"

Company Vickers Petroleum

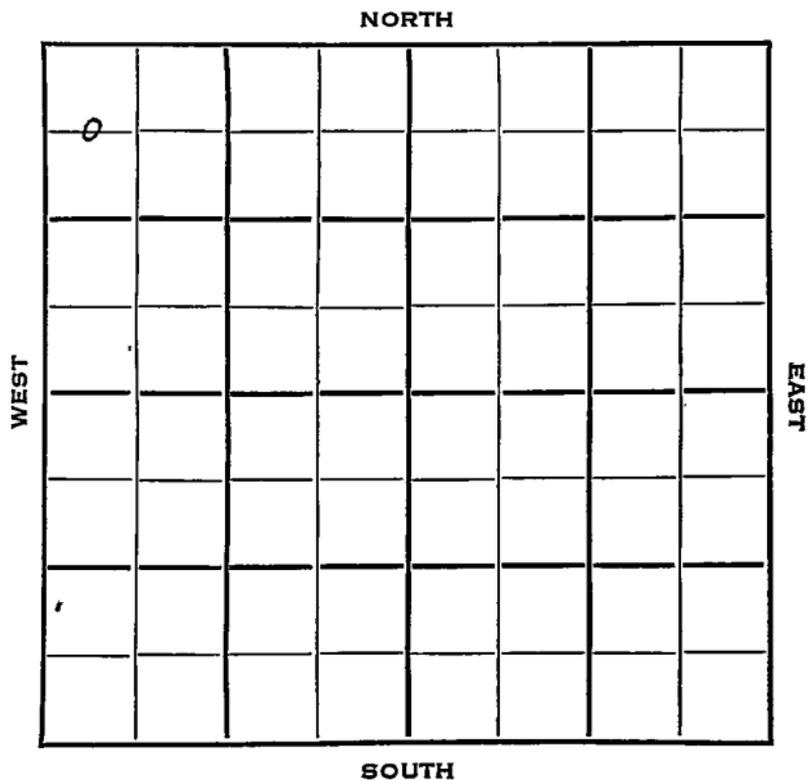

Sec. 6 Twp. 22 R. 13 W

Well No. # 3 Curtis "B" Farm

Vickers Petroleum Company

Jayhawk Drlg. Contractor


660 Ft. from N. Line

\_\_\_\_\_ Ft. from S. Line

\_\_\_\_\_ Ft. from E. Line

243 Ft. from W. Line

G W L NW NW

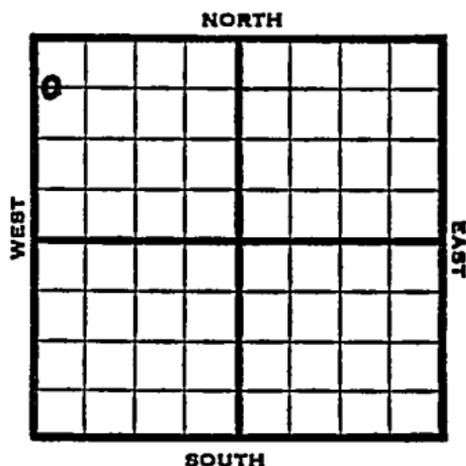

1953 Elev. 1915' REPORT

2/11 Spud 2-10-53  
8" @ 343

2/19 Anhy 798  
Drlg. 3000'

2/26 Heeb 3244 Br. Li 3367 Lans 3379  
RTD 3610 5" @ 3610

3/11 Spud 2-10-53 Oil well TD 3610  
8" @ 343 Anhy 798 Heeb 3244  
Br line 3367 Lans 3379 TD 3610  
5" @ 3610 CO to 3575 12/3405-09  
12/3409-13 12/3407-11 wtr & SO  
FU 1300' oil 12 hr. S & F/15 BOPH  
Comp. 546 BOPD 1% wtr.

**COMPLETED**

County Stafford State Kansas

Sec. 6 (Blk. 22) (Sur. Rge.) 13W Map No.

Operator Vickers Petroleum

Well No. 3 Farm Gurtis "B"

Elev. Location C W L NW NW


600 Ft. From N Line NW

243 Ft. From W Line Quarter

1st. Report FEB 11 1953

Completion

Remarks

Jayhawk Drlg. - Contr.

Spudding Date 2-10-53

Drlg. Data

8" @ 343

County Stafford State Kansas

Sec. 6 (Blk. 22) (Sur. 13W) (Twp. 22) (Rge. 13W) Map No.

Operator Vickers Pet.

Well No. 3 Farm Curtis "B"

Elev. 1915 Location C W L NW NW


600 Ft. From N Line NW

243 Ft. From W Line Quarter

Ist. Report

Completion MAR 11 1953

Remarks

Jayhawk Drlg. - Contr.

Spudding Date 2-10-53

Drlg. Data Oil well TD 3610

8" @ 343 Anhy 798 Heeb. 3244

Br. lime 3367 Lans. 3379 TD 3610

5" @ 3610 CO to 3575 12/ 3405-09

12/ 3409-13 12/ 3407-11 wtr & SO

FU 1300' oil 12 hr. S & F/ 15 boph

Comp. 546 bopd 1% wtr.