


Section 6 Township 22 Range 13W

Well No. 4 Schmid

Company Skelly

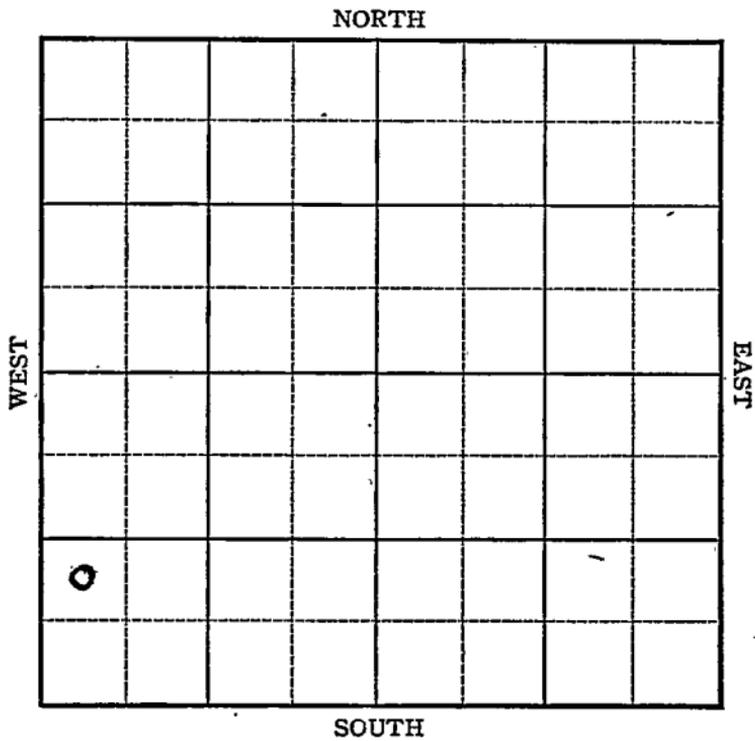

Sec. 6 Twp. 22 R. 13W

Well No. #4 Schmid Farm

Skelly Company

Curtis


\_\_\_\_\_ Ft. from N. Line

990 \_\_\_\_\_ Ft. from S. Line

\_\_\_\_\_ Ft. from E. Line

330 \_\_\_\_\_ Ft. from W. Line

NW SW SW

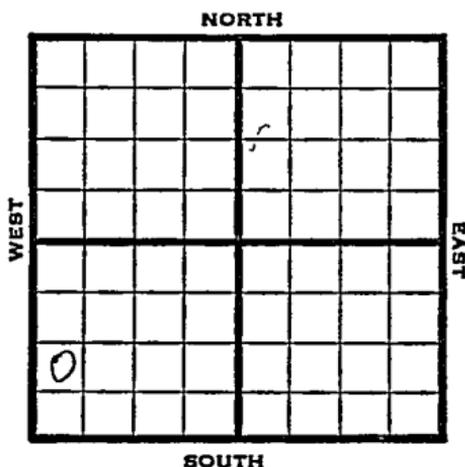

1946

Elev. 1933

REPORT

5/1 Location

5/7 8" @ 576  
Drlg 1410'

5/14 Lans 3387, SO 3422-25  
3555-62, 3574-79  
Cong 3649  
Simp 3697  
Arb 3704-08 TD SO  
5" @ 3704 RUST

5/21 " " "

5/29 TD 3716' 500 acid.  
Swb. 50 oil in 2 hrs.

6/5 Arb. 3704  
5" @ 3704  
500 acid.  
TD 3714  
Pump 649 Pot.  
Gray. 36.0

COMPLETED

**KANSAS**

Kansas Pool Name Curtis

Map No. 82 Sec. 6 Twp. 22 R. 13W

Well No. 4 Schmid

Skelly Company

FIRST REPORT Contractor

NW SW SW

**SECTION PLAT**

           Ft. from N. Line

990 Ft. from S. Line

           Ft. from E. Line

330 Ft. from W. Line

o			

Stafford County

Location X

Rig up           

Drilling and Remarks:           

**RECORD**

Cased            in.,            ft.

Sand           

Gas           

Oil           

Total Depth           

**PRODUCTION**

1st 24 hrs. Nat.           

1st 24 hrs. after shot           

Gas            Cu. Ft.

Dry Hole           

Abandoned           

Date

MAY 1 1946 19

S. J. LEWIS Scout

