


Section 6 Township 22 Range 13-W

Well No. #2 Schmidt

Company Skelly

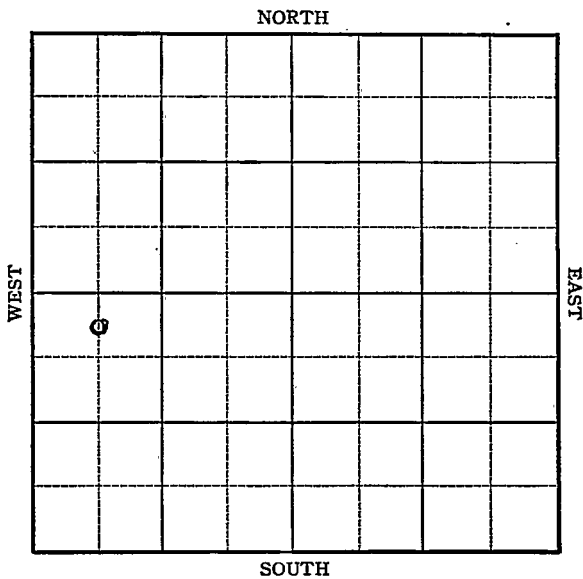


O. W. P. B. KANSAS Stafford
Sec. 6 Twp. 22 R. 13-W

Well No. #2 Schmidt
Skelly Company

O.W.W.O. Farm
7/14/54

CORTIS POOL

330 Ft. from N. Line
 Ft. from S. Line
 Ft. from E. Line
660 Ft. from W. Line

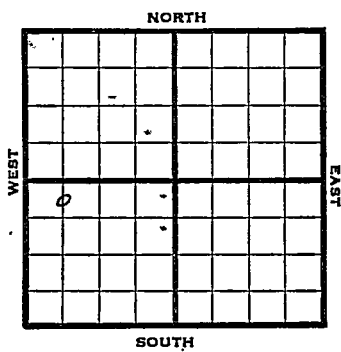

C N L NW SW

1945	Elev. 1921'	REPORT
12/5	Location	
12/12	"	
12/20	"	
12/29	R U R	
1946		
1/10	10" - 558'	Drlg. 2234'
1/14	Lans. 3380'	Cong. 3632'
	Simp Sand 3693'	Arb. 3699'
	T.D. 3710'	Run 5".
1/24	5" - 3703'	RUST.
1/31	500 acid.	Pump 106 oil in 7 hours.
2/6	Arb. 3699.	
	5" @ 3703'	
	500 acid.	
	TD 3710	
	Echo Pot. 2845	
	Grav. 33.0	

COMPLETED

OVER

1953
12/2

O. W. P. B.

Oil well TD 3710' Lans. 3380
Arb. 3690' OTD 3710' 5" @ 3703
PB 3639' 41/3528-35 500 A
S/4 BO 12 BW 13 hr. 2000 A
S/8 BO 10 BW 9 hr. PB 3515
28/3508-13 500 A S/3 BO 22 BW
17 hr. CO 3639 S/5 BO 12 BW 7 hr.
47/3457-65 500 A S/40 BO 40 BW
8 hr.
Comp. 60 BOPD 83 BW

FIRST REPORT

~~COMPLETED~~

O.W.W.O.

1954
7/14

Lans 3382', Cong 3632', Simp 3688',
Arb. 3690'
5" @ 3703'
TD 3710'
CO to 3710'
P/10 bopd 230 bw

7/21

Oil well TD 3710 Lans 3382
ong. 3632 Simp 3688
Arb. 3690 5" @ 3703 TD 3710
CO to 3710 Comp. 10 BOPD 230 BW

COMPLETED

KANSAS Pool Name CurtisMap No. K-82 Sec. 6 Twp. 22 R. 13WWell No. 2 SchmidtSkelly

Company

~~FIRST REPORT~~

Contractor

C N L NW SW

SECTION PLAT

0			

330 Ft. from N. Line Ft. from S. Line Ft. from E. Line660 Ft. from W. LineStafford CountyLocation XRig up

Drilling and Remarks:

RECORD

Cased in., ft.Sand Gas Oil Total Depth

PRODUCTION

1st 24 hrs. Nat. 1st 24 hrs. after shot Gas Cu. Ft.Dry Hole Abandoned

Date

DEC 5 1945 19 S. J. LEWIS Scout

Kansas Pool Name Curtis**KANSAS**Map No. 82 Sec. 6 Twp. 22 R. 13WWell No. 2 SchmidtSkelly


Company

COMPLETED

Contractor

*E11921***SECTION PLAT**

C N L NW SW

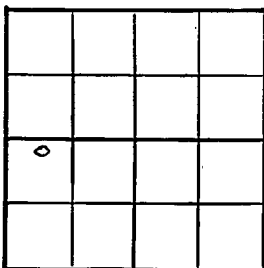330 Ft. from N. Line Ft. from S. Line Ft. from E. Line660 Ft. from W. LineStafford CountyLocation Rig up

Drilling and Remarks:

*Per 3685**5" @ 3700**500 @ 3700**Ech 2845**332 1/2***RECORD**Cased in., ft.Sand Gas Oil Total Depth 3710**PRODUCTION**1st 24 hrs. Nat. 1st 24 hrs. after shot Gas Cu. Ft.Dry Hole Abandoned

Date

FEB 6 1946

19S. I. LEWISScout

O. W. P. B.

County Stafford State Kansas

Sec. 6 (Blk. Twp.) 22 (Sur. Rge.) 13^W Map No.

Operator **Skelly Oil** A

Well No. **2** Farm **Schmid**

Elev. 1921 Location C N L NW SW

FIRST REPORT

COMPLETE

330 Ft. From N Line SW

660 Ft. From W Line Quarter

1st. Report DEC 2 1953

Completion DEC 2 1953

Remarks **OWPB**

~~O. W. P. B.~~

Spudding Date

Drilg. Data Oil well TD 3710

Lang. 3380 Arb. 3690 OTD 3710 5th @ 3703

PB 3639 41/ 3528-35 500 A S/ 4 bo

12 bw 13 hr. 2000 A S/ 8 bo 10 bw

9 hr. PB 3515 28/ 3508-13 500 A

S/ 3 bo 22 bw 17 hr. CO 3639

S/ 5 bo 12 bw 7 hr. 47/ 3457-65

500 A S/ 40 bo 40 bw 8 hr.

Comp. 60 bopd 83 bw

J. G. McHEE

O.W.W.O.

County **Stafford** State **Kansas**Sec. **6** (Blk.) **22** (Sur.) **13W** Map No.Operator **Skelly Oil**Well No. **2** Farm **Schmidt**Elev. **1921** Location **C N¹/₂ NW SW**

FIRST REPORT

330 Ft. From **N** Line **SW****660** Ft. From **W** Line Quarter1st. Report **JUL 14 1954**

Completion

Remarks **OWNED**


O.W.W.O.

Spudding Date

Drlg. Data **Curtis Pool****Lans. 5382 Cong. 3632 Simp. 3688****Arb. 3690 5" @ 3703 TD 3710****CO to 3710 P/ 10 bopd 230 bw**

J. G. McGEHEE

O.W.W.O.

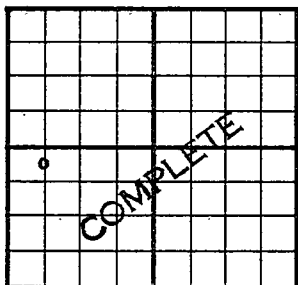County Stafford State KansasSec. 6 (Blk. Twp.) 22 (Sur. Rge.) 13W Map No.Operator Skelly OilWell No. 2 Farm SchmidElev. 1921 Location C N $\frac{1}{2}$ NW SW330 Ft. From N Line SW660 Ft. From W Line Quarter

1st. Report

Completion JUL 21 1954

Remarks

OWWO

O.W.W.O.

Spudding Date

Drlg. Data Oil well TD 3710Lans. 3382 Cong. 3632 Simp. 3688Arb. 3690 5" @ 3703 TD 3710CO to 3710 Comp. 10 bopd 230 bw