


Section 6 Township 22 Range 13 W

Well No. # 3 Curtis "A"

Company Vickers Pet.

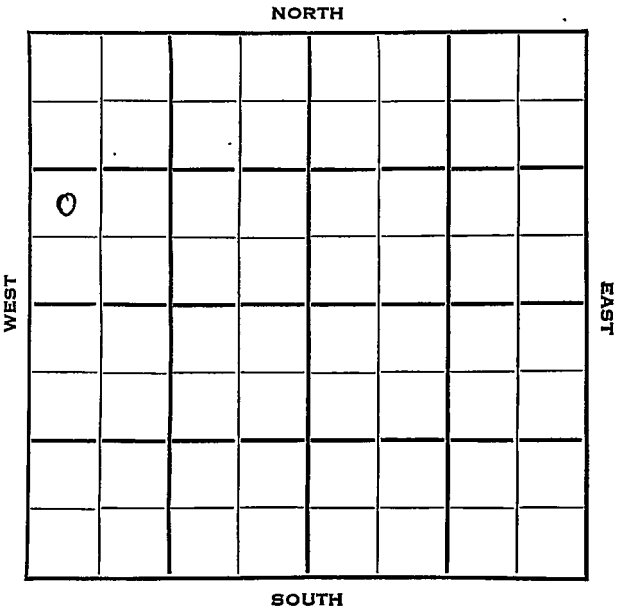

Stafford

KANSAS

SEC.	TWP.	R.
6	22	13W ✓

WELL NO. #3 Curtis "A" FARM

COMPANY

Vickers Pet.

CONTRACTOR

Jayhawk


Curtis Pool

Ft. from N. Line

990 Ft. from S. Line

Ft. from E. Line

330 Ft. from W. Line

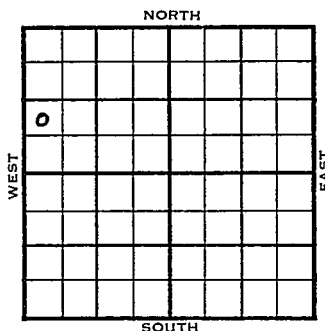

NW SW NW

ELEVATION
1917'

REPORT

1953

11/30

R U R

12/9

8" @ 340'
Drlg. 3115'

12/16

Heeb 3243' V 3638' Simp 3671'
Arb. 3721'
Schl tops: Br li 3362 Lans 3375
V 3638' Simp 3671
RTD 3723 5" @ 3722

1954

1/6

Spud 12-1-53
Oil Well
TD 3725'
8" @ 340'
Heeb 3243', Viola 3638', Simp 3671'
Arb 3721'
Schlumberger Tops: Br. Lime 3362, Lans
3721', Viola 3638', Simp 3671',
TD 3723'
5" @ 3722'
DD 3725' S/ 4 boph 10% wtr.
Comp 46 bopd 35% wtr.

COMPLETED

J. G. McGEHEE

County Stafford State Kansas
 Sec. 6 (Blk. 22 (Sur. 13W Map No.
 (Twp.) (Rge.)
 Operator Vickers Pet.
 Well No. 3 Farm Curtis "A"
 Elev. 1917 Location NW SW NW

0							

990 Ft. From S Line NW
 330 Ft. From W Line Quarter

1st. Report

Completion JAN 6 1954

Remarks Curtis Pool

Jayhawk - Contr.

Spudding Date 12-1-53

Drlg. Data Oil well TD 3725

8" @ 340 Heeb. 3243 Viola 3638

Simp. 3671 Arb. 3721 SCHLUMBERGER TOPS:

Br. lime 3362 Lans. 3375 Viola 3638

Simp. 3671 TD 3723 5" @ 3722

DD 3725 S/ 4 boph 10% wtr.

Comp. 46 bopd 35% wtr.

J. G. McGEHEE