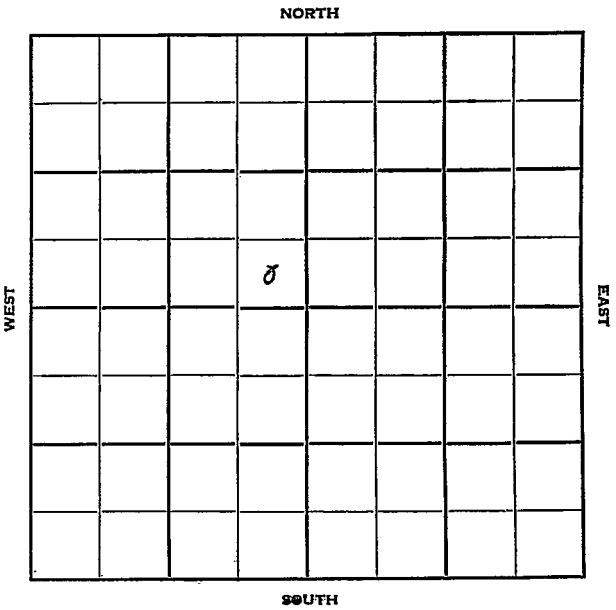


Section 6 Township 22 Range 14WWell No. #1 RussellCompany Westgate-Greenland

Stafford

KANSAS

Sec. 6 Twp. 22 R. 14 W

Well No. # 1 Russell Farm

Westgate-Greenland Company

Jackson Drlg. Contractor

Wildcat

Ft. from N. Line


330 Ft. from S. Line

330 Ft. from E. Line

Ft. from W. Line

SE SE NW

Cities Service farmout

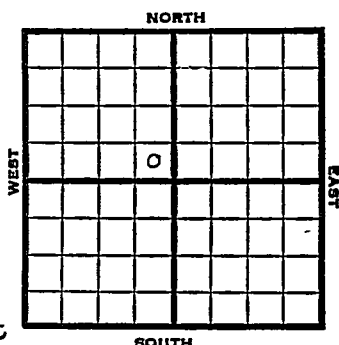


1951 Elev. 1961' REPORT

5/29 Location

7/11 Spud 6-19-51 D & A TD 3895'
D & A TD 3895' 8" @ 258'
Br. line 3456' Lans. 3476'
DST 3586-94 open 1 hr. rec 60' HOCM
150' water
DST 3609-31 open 1 hr. rec 120' HOCM
Cong. 3757' Viola 3767' Simp. 3831
Arb. 3879' TD 3895'
D & A

ABANDONED

J. E. TYRA

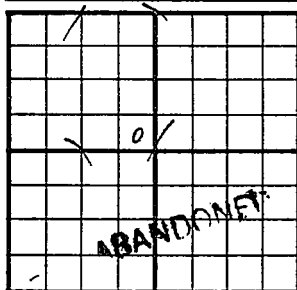County Stafford State KansasSec. 6 (^{Bk.}Twp.) 22 (^{Sur.}Rge.) 14W Map No.Operator Westgate-GreenlandWell No. 1 Farm RussellElev. 1961 Location SE SE NW330Ft. From S Line NW330Ft. From E Line Quarter

1st. Report

Completion JUL 11 1951Remarks WildcatJackson Drlg. - Contr.Spudding Date 6-19-51Drlg. Data D & A TD 38958" @ 258 Br. lime 3456 Lans. 3476DST 3586-94 open 1 hr. Rec. 60' hoc
cm 150' water DST 3609-31open 1 hr. Rec. 120' hocmCong. 3757 Viola 3767 Simp. 3831Arb. 3879 TD 3895D & A

J. E. TYRA