

Section 6 Township 22 Range 15WWell No. #1 YeagerCompany Schermerhorn Oil

NORTH

WEST

							0

EAST

SOUTH

Pawnee

KANSAS

Sec. 6 Twp. 22 R. 15 W

Well No. # 1 Yeager Farm

Schermerhorn Oil Company

Wildcat Contractor


Ft. from N. Line

330 Ft. from S. Line

330 Ft. from E. Line

Ft. from W. Line

SE SE SE

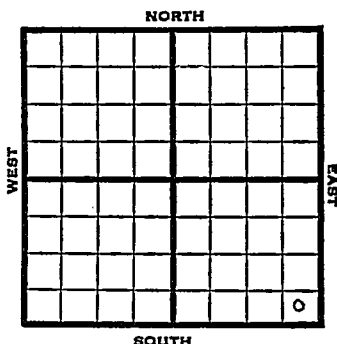

1951

Elev. 1985' REPORT

10/3

Drilling

10/17

Spud 9-30-51

D&A TD 3948

13" @ 336

Anhy 935

Br. 1m. 3498

Heeb. 3392

Lans. 3512

DST 3538-64 open 1 hr.

Rec. 90' GCM & Wtr. SSO

Cong. 3823

Simp. 3890

Arb. 3939

DST 3939-48 open 1 hr.

Rec. 1170' sul. wtr.

D&A

ABANDONED

Sec. 6 (Blk. Twp.) 22 (Sur. Rge.) 15W Map No.

Well No. 1 Farm Yeager

Elev.	Location	SE SE SE
-------	----------	----------

[illegible]

330 Ft. From E Line Quarter

1st. Report OCT 3 1951

Completion


Remarks

Spudding Date

Drig. Data **Wildcat**

drle:

County Pawnee State Kansas
 Sec. 6 (Blk. Twp.) 22 (Sur. Rge.) 15W Map No. _____
 Operator Schermerhorn Oil
 Well No. 1 Farm Yeager
 Elev. 1985 Location SE SE SE

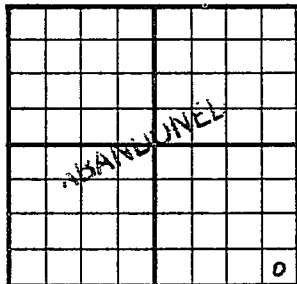

330 Ft. From S Line SE

330 Ft. From E Line Quarter

Ist. Report

Completion OCT 17 1951

Remarks Wildcat

Spudding Date 9-30-51

Drlg. Data D & A TD 3948

13" @ 336 Anhy 935 Heeb. 3392

Br. lime 3498 Lans. 3512 DST 3538-64

open 1 hr. Rec. 90' gcm & water SSO

Cong. 3823 Simp. 3890 Arb. 3939

DST 3939-48 open 1 hr. Rec. 1170' sul.wat

D & A

J. E. TYRA