

KANSAS

FORM 51 5M 10-41 PETROL

Reno

Section 6 Township 22 Range 9-W

Well No. 1 Halton


Company *Globe Oil*
~~W. Appleman & Hollow Drlg.~~

NORTH

Wildcat

WEST

EAST

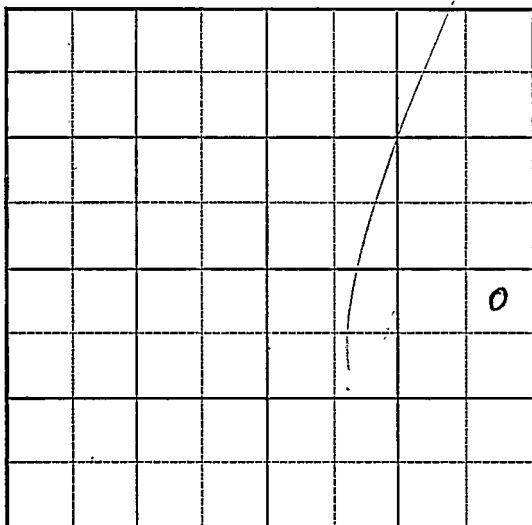

SOUTH

KANSAS

Reno

Sec. 6 Twp. 22 R. 9-W

Well No. #1 Haltom Farm

N. Appleman & Hollow Drlg. Company

(Wildcat)

330

Ft. from N. Line


Ft. from S. Line

330

Ft. from E. Line

Ft. from W. Line

Elev. 1746

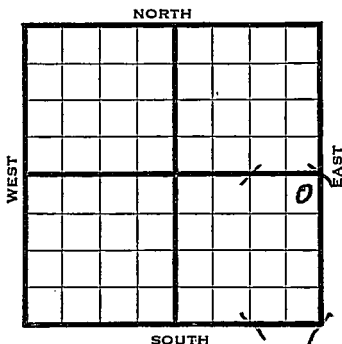

1942

REPORT

7/8

8" - 254' WOC.

7/15

Anhy. 530' Drlg. 3000'

7/22

Lans. 3181'

Cong. 3466'

Kind 3500'

Viola 3528'

Simp. 3609'

Arb. 3668'

T.D. 3708'

No shows.

ABANDONED

KANSAS

Reno

Map No. 79 Sec. 6 Twp. 22 R. 9WWell No. 1 HaltomN. Appleman & Hollow Drilling Company**FIRST REPORT**

Contractor

NE SE

SECTION PLAT

330


Ft. from N. Line

Ft. from S. Line

330

Ft. from E. Line

Ft. from W. Line

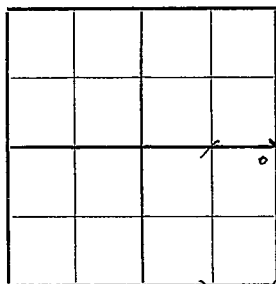WILDCAT

Location _____

Rig up _____

Drilling and Remarks:

8" - 254'

Waiting on
cement

RECORD

Cased _____ in., _____ ft.

Sand _____

Gas _____

Oil _____

Total Depth _____

PRODUCTION

1st 24 hrs. Nat. _____

1st 24 hrs. after shot _____

Gas _____ Cu. Ft.

Dry Hole _____

Abandoned _____

Date

JUL 8 1942 19S. J. LEWIS Scout

Reno

KANSAS

Map No. 49 Sec. 6 Twp. 22 R. 9WWell No. 1 HaltonN. Appleman & Hollow Company
Drig.ABANDONED Contractor

NE SE

330 Ft. from N. Line Ft. from S. Line330 Ft. from E. Line Ft. from W. Line

SECTION PLAT

WILDCAT

Location Rig up

Drilling and Remarks:

*Lease 3181**Comp 3466.**Prod 3500**Vid 3528**Snup 3609**Ret 3668.**No more*

RECORD

Cased in., ft.Sand Gas Oil Total Depth 3208.

PRODUCTION

1st 24 hrs. Nat. 1st 24 hrs. after shot Gas Cu. Ft.Dry Hole Abandoned Date

JUL 22 1942

19

S. J. LEWIS Scout

O.W.W.O.

WILDCAT

FORM 513 SUNRAY

County Reno Elev. 1716
 Sec. 6 Twp. 22 Rge. 9W
 Company Globe Oil
 Farm Name Haltom No. 1

TOPS	DEPTH	LOG	DATUM	Loc. in Sec.
Anh.				NE NE SE
Tr.				<u>OWWO</u>
H.				
Tr.				
Dg.				
BL.				
L.	3181			Geol.
K.C.				Contr.
B.K.C.				
Ce.				
C.	3166			Pool
M.				<u>Wildcat</u>
M.	3500			
K.				
Mz.				
Ma.				
V.	3528			
S.				
S.	3609			
A.	3668			
R.				
PE.				
G.				
T.D.				

FIRST REPORT

FEB 27 '57

Date Comm.

OTD 3718 to work over

12

Co.

County Reno Elev. 1746
 Sec. 6 Twp. 22 Rge. 9W
 Company Globe Oil
 FarmName Haltom No. 1

TOPS	DEPTH	LOG	DATUM
Anh.			
TP.			
H.			
Tr.			
Dg.			
BL.			
L.	3181		
K.C.			
B.K.C.			
Ce.			
C.	3466		
M.			
M.			
K.	3500		
Mz.			
Mo.			
V.	3528		
S.			
S.	3609		
A.	3668		
R.			
PE.			
G.			
T.D.	3730		

Loc. in Sec. _____
 N^o N^o S^o

Geol. _____

Contr. _____

Pool _____

Indicat. _____

COMPLETE

MAY 15 57

Use.

No.

Sec.

T.

Date Comm.

OTD 3718 to work over in 5.57 DST

3592-3618 op 2 1/2 hrs 1020'

gas rec 155' Md'y oil + 30'

OCW FP 30-170 B-JTR 1020/30

5 1/2 3728 H.P. CO 3650 pf 40/

3610-20 300 A tst 180 + 18WPK

750 A tst MAR 20 57 1 1/4 B0 + 1 1/4

Bwph 24 hrs FRC 2 1/4 Boph.

+ 2 1/4 Bwph POF

est P. 45 BOPd + 58% wth gas 42

APR 24 57 MAY 1 57 MAY 8 57 MAY 15 57

L. 45 Bopd + 50 g/w
grau 40.5°