

Section 6 Township 22 Range 11WWell No. #1 MelliesCompany Huber et al

Spangenberg Pool NORTH

WEST

EAST

SOUTH

KANSAS

Stafford

Sec. 6 Twp. 22 R. 11W

Well No. #1 Mellies Farm

Huber et al Company

Spangenberg Pool


330' Ft. from N. Line

 Ft. from S. Line

330' Ft. from E. Line

 Ft. from W. Line

NE SE

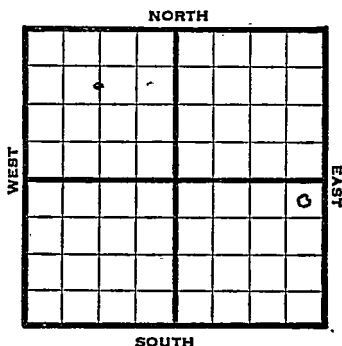

1948 Eley. 1772' REPORT

2/18 Location

2/25 8" @ 208'
Drlg. 1495'

3/3 Lansing 3202'
Drlg. 3475'

3/10 Congl. 3477'
Viola. 3521'
Simp. 3565'
Arb. 3605'
TD 3617'

ABANDONED

Map No. _____ Sec. 6 Twp. 22 R. 11W

Well No. 1 Mellies

Huber et al. Company

FIRST REPORT

Contractor

NE SE


SECTION PLAT

330 Ft. from N. Line

_____ Ft. from S. Line

330 Ft. from E. Line

_____ Ft. from W. Line

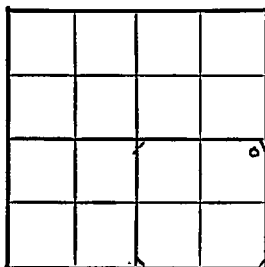

Stafford County

Location X

Rig up _____

Drilling and Remarks:

RECORD

Cased _____ in., _____ ft.

Sand _____

Gas _____

Oil _____

Total Depth _____

PRODUCTION

1st 24 hrs. Nat. _____

1st 24 hrs. after shot _____

Gas _____ Cu. Ft.

Dry Hole _____

Abandoned _____

Date

FEB 18 1948 19

S. I. LEWIS Scout

Map No. 46 Sec. 6 Twp. 22 R. 11W

Well No. 1 Mellies

Huber et al. Company

ABANDONED Contractor

NE SE


E. 11/1972
SECTION PLAT

330 Ft. from N. Line

 Ft. from S. Line

330 Ft. from E. Line

 Ft. from W. Line

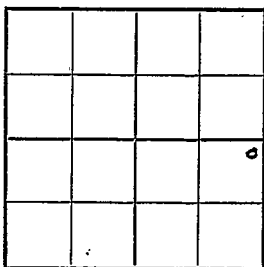

Stafford County

Location

Rig up

Drilling and Remarks:

Cong 3477
Vista 3521
Imp 3565
Cr & 3605

RECORD

Cased in., ft.

Sand

Gas

Oil

Total Depth 3617

PRODUCTION

1st 24 hrs. Nat

1st 24 hrs. after shot

Gas Cu. Ft.

Dry Hole

Abandoned

Date

MAR 10 1948

MAR 10 1948 19 S. J. LEWIS Scout