

Section 6 Township 22 Range 12W
1 Blackburn

Well No. _____

Company Westgate-Greenland

Drach -

NORTH

WEST

EAST

| | | | | | | | |
|--|--|--|--|--|--|---|--|
| | | | | | | | |
| | | | | | | | |
| | | | | | | | |
| | | | | | | 0 | |
| | | | | | | | |
| | | | | | | | |
| | | | | | | | |
| | | | | | | | |

SOUTH

KANSAS

Stafford



Sec. 6 Twp. 22 R. 12W

Well No. #1 Blackburn Farm

Westgate-Greenland Company


Drach Pool

_____ Ft. from N. Line

339' Ft. from S. Line

990' Ft. from E. Line

_____ Ft. from W. Line

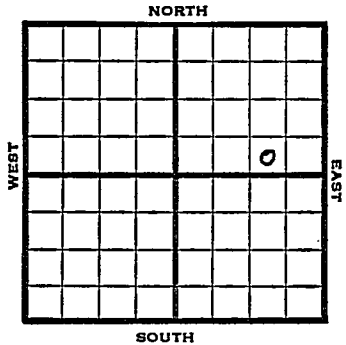

SW SE NE

1949 Elev 1872' REPORT

- 4/13 8" @ 305'
- 4/20 Drlg. 3450'
- 4/27 Lansing 3315'
Arbuckle 3671'
TD 3681'
- 5/4 5" @ 3670'
TD 3681'
Arb. 3671'
Aband.

ABANDONED

Kansas

Map No. _____ Sec. 6 Twp. 22 R. 12^W

Well No. 1 Blackburn

Westgate-Greenland

Company

FIRST REPORT

Contractor

SW SE NE


SECTION PLAT

_____ Ft. from N. Line

339 Ft. from S. Line

990 Ft. from E. Line

_____ Ft. from W. Line

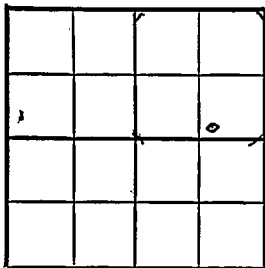

Stafford County

Location _____

Rig up _____

Drilling and Remarks:

8" @ 305

RECORD

Cased _____ in., _____ ft.

Sand _____

Gas _____

Oil _____

Total Depth _____

PRODUCTION

1st 24 hrs. Nat. _____

1st 24 hrs. after shot _____

Gas _____ Cu. Ft.

Dry Hole _____

Abandoned _____

Date

APR 13 1949 19

S. J. LEWIS

Scout

Map No. R46 Sec. 6 Twp. 22 R. 12W

Well No. 1 Blackburn

Westgate-Greenland

Company

ABANDONED

Contractor

SW SE NE

E 1, 1972
SECTION PLAT

_____ Ft. from N. Line

330 Ft. from S. Line

990 Ft. from E. Line

_____ Ft. from W. Line

| | | | |
|--|--|--|---|
| | | | |
| | | | 0 |
| | | | |
| | | | |

Stafford County

Location _____

Rig up _____

Drilling and Remarks:

Cur 3671

RECORD

Cased _____ in., _____ ft.

Sand _____

Gas _____

Oil _____

Total Depth 3687

PRODUCTION

1st 24 hrs. Nat. _____

1st 24 hrs. after shot _____

Gas _____ Cu. Ft.

Dry Hole _____

Abandoned _____

Date

MAY 4 1949 19

S. J. LEWIS Scout