

KANSAS

FORM 51 5M 10-41 PETROL


Harvey

Section 6 Township 22 Range 1-W

Well No. #1 Lagree

Company Keener Oil et al

Semi-wildcat

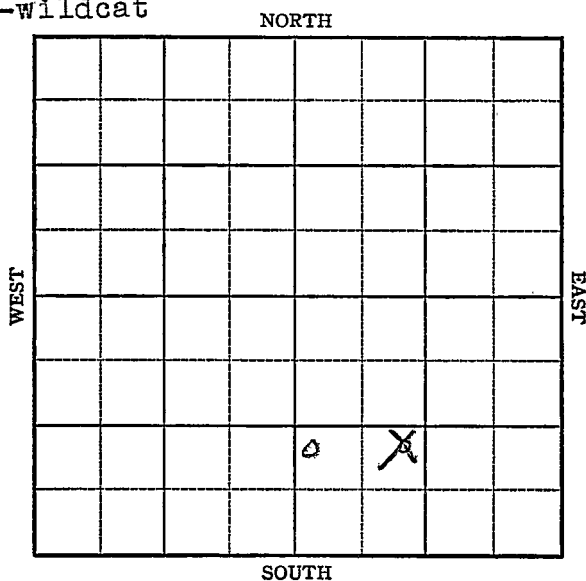

KANSAS Harvey

Sec. 6 Twp. 22 R. 1-W

Well No. #1 Lagree Farm

Keener Oil et al _____ Company

(Semi-Wildeat

Ft. from N. Line

990 Ft. from S. Line


Ft. from E. Line

330


Ft. from W. Line

Elw. 1462

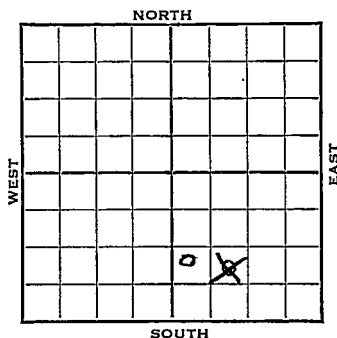

1942

REPORT

9/16 | 8" - 150. Drlg. 346'

9/23' | Drlg SD

9/30 Drlg. 3280 Lans. 2312
Miss. 2920 Misener 3270
Hunton 3272-SO 3274-76

10/7	Viola 3386 Arb. 3504 TD 3530 no shows to run 5" - 3417
------	---

10/14 5" @ 3417 HPW PB

10/21	11	11	11	11	11
-------	----	----	----	----	----

10/28 6 shots 3276-81
12 shots 3276-80 S water &
trace oil

11/4	600 acid swap 29oil plus 112 Bbls water in 8 hrs through a tubing
------	---

11/11	"	"	"	"
-------	---	---	---	---

11/18	"	"	"	"
-------	---	---	---	---

11/24	11	11	11
-------	----	----	----

12/2	"	"	"	"
------	---	---	---	---

12/9	11	11	11	11
------	----	----	----	----

12/16	"	"	"	"
-------	---	---	---	---

12/22	"	"	"	"
-------	---	---	---	---

12/29	11	12	13	14
-------	----	----	----	----

OVER

1943

1/6

600 acid swab 29 bil-plug
12 Bbls water in 8 hrs thru
tubing

1/13

Arb. 3504
5" casing set 3417'
T.D. 3530'
Water

ABANDONED

KANSAS

Harvey

Map No. 43 Sec. 6 Twp. 22 R. 1WWell No. 1 LagreeKeener Oil et al. Company**FIRST REPORT**

Contractor

NE SW SE

SECTION PLAT Ft. from N. Line990 Ft. from S. Line Ft. from E. Line990 Ft. from W. Line

SEMI-WILDCATLocation Rig up Drilling and Remarks: 8"-150'Drilg. 346'**RECORD**Cased in., ft.Sand Gas Oil Total Depth **PRODUCTION**1st 24 hrs. Nat. 1st 24 hrs. after shot Gas Cu. Ft.Dry Hole Abandoned

Date

SEP 16 194219S. J. LEWISScout

Harvey

Map No. 43 Sec. 6 Twp. 22 R. 1WWell No. 1 Lagree

Keener Oil etal. Company

CORRECTION Contractor

NW SW SE

SECTION PLAT

		o	

Ft. from N. Line

990 Ft. from S. Line

Ft. from E. Line

330 Ft. from W. Line

SEMI-WILDCAT

Location

Rig up

Drilling and Remarks:

Reported

NE SW SE

RECORD

Cased in, ft.

Sand

Gas

Oil

Total Depth

PRODUCTION

1st 24 hrs. Nat.

1st 24 hrs. after shot

Gas Cu. Ft.

Dry Hole

Abandoned

Date

SEP 23 1942

19

S. J. LEWIS Scout

Harvey

KANSAS

Map No. 43 Sec. 6 Twp. 22 R. 1WWell No. 1 LagreeKeener Oil et al. CompanyABANDONED Contractor

NW SW SE

 Ft. from N. Line990 Ft. from S. Line Ft. from E. Line330 Ft. from W. LineSEMI-
WILDCAT

SECTION PLAT

		o	

Location Rig up

Drilling and Remarks:

*Cr. 8504**5" 8417**Water*

RECORD

Cased in., ft.Sand Gas Oil Total Depth 3530

PRODUCTION

1st 24 hrs. Nat. 1st 24 hrs. after shot Gas Cu. Ft.Dry Hole Abandoned

Date

JAN 13 1943 19 S. I. LEWIS Scout