

Finney

KANSAS

6

22S

32W

SECTION _____ TOWNSHIP _____ RANGE _____

#2 Buck

WELL NO. _____

COMPANY _____

Kansas-Nebr. - 1

P A


Champlin

NORTH

C SW/4

WEST

EAST

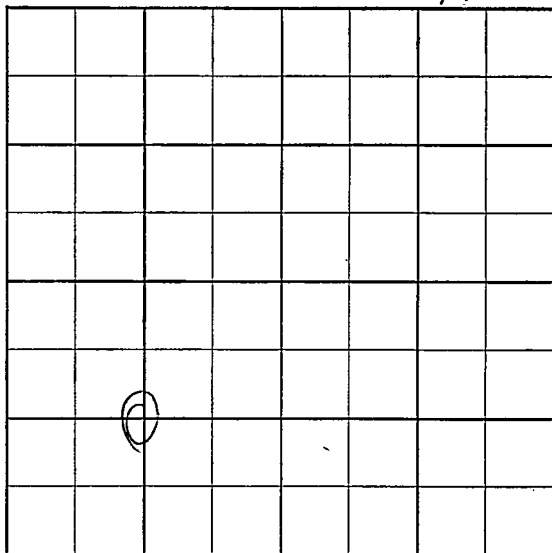

SOUTH

COMPANY Kansas-Nebr. NO. 2

FIRST REPORT
 OCT 30 57

LOC. _____ C SW/L

[illegible]

SPUD

~~Location~~

RGE

S-513-A

CO. ELEV.

SEC. TWP. RGE.

COMPANY NO.

COMPLETE

DEC 18 '57

FARM

LOC.

CRA
Champion

Log

Her 2579	+367
VIC 2613	+273
LK 2628	+258
Win 2680	+206

GEOL.

CONTR.

POOL

SPUD 11-6-57

8" 422/300

TD 2680 run log 5 1/2" 2679

1200 woc MICT

DD 2686 11 1/2" 1B wph SS

g SD CO 2670 20/2659-64

ga 2.500 mcf 1/2" ga

3.24 mcf +15 gwp 14 h

BP 2650 40/2614-24 40/

2629-24 40/ 5x2" ga

1.760 mcf NW run +bg

CO 2670 T&R

SI 88 hrs 20" opt 10

ga 4.256 mcf thru tbg

RP 405

2614-39

2659-64