

Section 7 Township 22 Range 13 WWell No. # 2 BaierCompany Sunray Oil

0							

NORTH

WEST

EAST

SOUTH

Stafford

KANSAS

SEC.	TWP.	R.
7	22	13W ✓

WELL NO.

#2 Baier

FARM

COMPANY

Sunray Oil

CONTRACTOR

Stickle Drlg.

Curtis Pool

Ft. from N. Line

990


Ft. from S. Line

Ft. from E. Line

330

Ft. from W. Line

NW SW NW

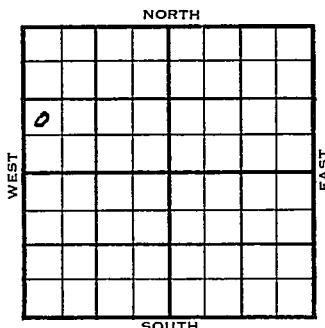


1953	ELEVATION	REPORT
	1918'	
12/22	M I R	
1954		
1/6	Spud 12-21-53	
	D & A	
	TD 3820'	
	8" @ 389'	
	Heeb 3281', Br. Lime 3409'	
	Lans 3422' B KC 3660',	
	DST 3666'-82' opn 1 hr, rec 10' Mud	
	O# Viola 3702', Simp 3740'	
	DST 3705'-50' opn 1 hr, rec 25' Mud	
	o# Simp 3789', Re-Arb 3792' Arb 3800'	
	TD 3820'	
	D & A	

ABANDONED

J. G. McGEHEE

County Stafford State Kansas
 Sec. 7 (Blk.) 22 (Sur.) 13W Map No.
 Operator Sunray Oil
 Well No. 2 Farm Baier
 Elev. 1918 Location NW SW NW

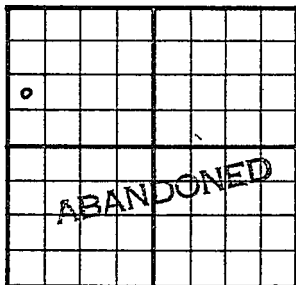

990 Ft. From S Line NW
330 Ft. From W Line Quarter
1st. Report
Completion JAN 6 1954
Remarks Curtis Pool
Stickle Drlg. - Contr.
Spudding Date 12-21-53

Drlg. Data D & A TD 3820
8" @ 389 Heeb. 3281 Br. lime 3409
Lans. 3422 B KC 3660 DST 3666-82
open 1 hr. Rec. 10' mud 0# Viola 3702
Simp. 3740 DST 3705-50 open 1 hr.
Rec. 25' mud 0# Simp. 3789
ReArb. 3792 Arb. 3800 TD 3820

D & A