

Stafford

FORM 51


KANSAS

Section 7 Township 22 Range 11W

Well No. 1 - Smith "A"

Company B & B Drlg

NORTH

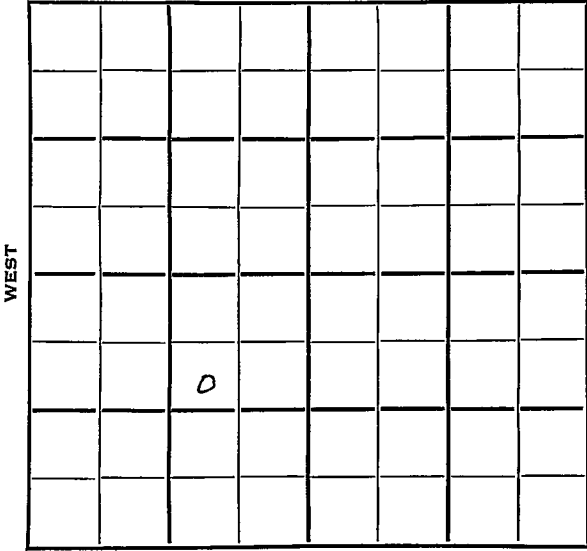

SOUTH

Stafford

KANSAS

Sec. 7 Twp. 22 R. 14WWell No. #1Smith"A" FarmB & B Drlg. CompanyB & B Drlg. Contractor

Wildcat


990 Ft. from N. Line

Ft. from S. Line

990 Ft. from E. Line

Ft. from W. Line

SW NE SW

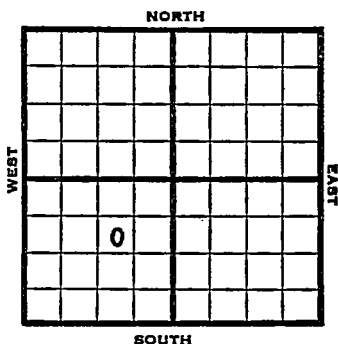

1953 Elev. 1961' REPORT

- 1/14 Spud 1-7-53
8" @ 293
Anhy 890
Drlg. 2435'
- 1/22 Br Li 3466, Lans 3476
DST 3635-44, 1 hr., 100' SW
1240#
DST 3655-65, 3/4 hrs., 60'
HOCM
DST 3676-3700, 1 hr., 2600'
gas, 1060' clean oil 1160#
Drlg.
- 1/29 Cong 3767' V 3775' Simp 3815'
Arb. 3877' RTD 3880' 5" @ 3879 CO
- 2/5 DD 3882, 1 bwph, DD 3884,
TD 3 BWPH
PB 3805
87/3768-3803, 500A
S/9 BOPH 12 hrs., G 38
POP
- 2/12 P/50 BOPD went dead,
PB 3702, 51/3689-3702, 31 B0 +
10 BW 2 hrs.
- 2/19 Dec. to 8 BFPH 40% oil, sq
CO Reperf 60/3689-3702,
1000A, S/8 BOPH + trace wtr.

OVER

1953

2/26 P/ $1\frac{1}{2}$ BOPH $\neq$ 50% wtr.

3/12 NR

3/19 P/14 BOPD + 50% wtr.

3/26 NR

4/2 "

4/9 NR

4/16 "

4/23 "

4/30 "

5/7 "

5/20 Spud 1-7-53

D & A

TD 3884'

8" @ 293'

Anhy 890, Be. Lime 3466, Lans 3476.

DST 3635-44 opn 1 hr, rec 100' sw.
1240#

DST 3655-65 opn 3/4 hr. Rec 60' hocm
0#

DST 3676-3700 opn 1 hr, rec 2600' gas
1060' clean oil 1160#

Cong 3767, Viola 3775, Simp 3815, Arb
3877

TD 3880

5" @ 3879'

DD 3882 1 bwph DD 3884 3 bwph

PB 3805 87/ 2768-3803 500 A S/ 9

boph 12 hr. P/ 50 bopd went dead

PB 3702 51/ 3689-3702 31 bo 10 bw

2 hr. dec. to 8 bfph 40% oil CO

60/ 3689-3702 1000 A S/ 8 boph P/ $1\frac{1}{2}$

boph 50% wtr. P/ 14 bopd 50% wtr.

48/ 3661-70 2500 A PB 3640 48/ 3611

24 1000 A

D & A.

ABANDONED

3877
1961
- 1916


3476
1961
- 1515

County **Stafford** State **Kansas**
 Sec. **7** (Blk. **22** (Sur. **14W** Map No.

Operator **B & B Drlg.**

Well No. **1** Farm **Smith "A"**

Elev. Location **SW NE SW**

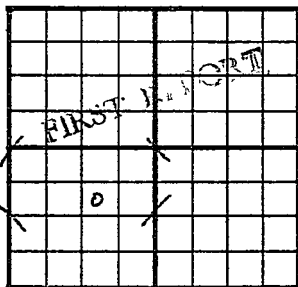

990 Ft. From **N** Line **SW**

990 Ft. From **E** Line **Quarter**

1st. Report **JAN 14 1953**

Completion

Remarks

B & B Drlg. - Contr.

Spudding Date **1-7-53**

Drig. Data **Wildcat**

8" @ 293 Any 890 drlg. 2435


Scout Cards	_____
Land Small Map	_____
Land Wall Map	_____
Tracings	_____
France Map	_____
Pierce River	_____
Misc.	_____

AD

JAN 16 1952

Drig. Data

County Stafford State Kansas
 Sec. 7 (Blk. 22 (Sur. 14W Map No.
 (Twp.) (Rge.)
 Operator B & B Drlg.
 Well No. 1 Farm Smith "A"
 Elev. 1961 Location SW NE SW

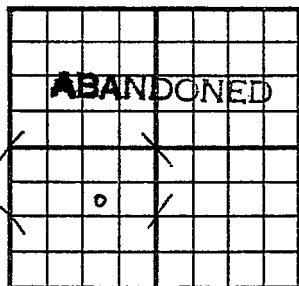

990 Ft. From N Line SW
990 Ft. From E Line Quarter
 1st. Report
 Completion MAY 20 1953
 Remarks Wildcat
B & B Drlg. - Contr.
 Spudding Date 1-7-53

Drlg. Data D & A TD 3884
8" @ 293 Anhy 890 Br. lime 3466
Lans. 3476 DST 3635-44 open 1 hr.
Rec. 100' sw 1240# DST 3655-65
open 3/4 hr. Rec. 60' hoom 0#
DST 3676-3700 open 1 hr. Rec. 2600' gas
1060' clean oil 1160# Cong. 3767
Viola 3775 Simp. 3815 Arb. 3877
TD 3880 5" @ 3879 DD 3882 1 bwph
DD 3884 3 bwph PB 3805 87/ 3768-3803
500 A (S/ 9 boph ^{SIMPSON} 12 hr. P/ 50 bopd)
went dead PB 3702 51/ 3689-3702
31 bo 10 bw 2 hr. dec. to 8 bfph
40% oil CO 60/ 3689-3702 1000 A
(S/ 8 boph) P/ 1 1/2 boph 50% wtr.

J. G. McGEHEE

Orig. Data

F/ 14 bopd

2500 A / PB 3640

1000 A

50% wtr. 48 / 3661-70

Misc 48 / 361434

Pierce Map

France Map

Tracings

Land Wall Map

Land Small Map

Scout Cards

MAY 26 1953
CP