

Reno

KANSAS

SEC.	TWP.	R.
7	22	9 W

WELL NO.

1 Drake

FARM

COMPANY

Globe Oil

CONTRACTOR

Sterling

Wildcat


990 Ft. from N. Line

Ft. from S. Line

Ft. from E. Line

990 Ft. from W. Line

SE NW NW

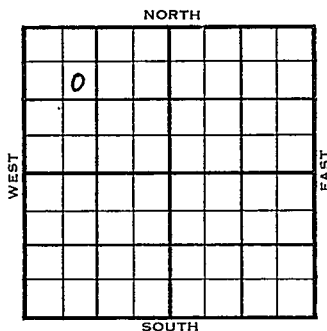

1954

ELEVATION

1748'

REPORT

7/14

Location

7/21

8" @ 351'

8/4

Spud 7-15-54 D & A TD 3721
 8" @ 351' Any 342 Top 2632
 Heeb 2932 Tor. 2957 B. Oread 2969
 Br. lime 3076 Lans 3103
 Viola 3572
 DST 3562-3600 open 40 min rec 30' mud
 O# Simp. sh. 3616 Simp sd 3625
 DST 3615-35 open 1 hr rec 240' SW
 1000# Arb. 3684 TD 3721
 D & A

ABANDONED

