


DX 78-1 Stafford

KANSAS

Section 7 Township 22 Range 11W

Well No. #1 Wolf "B"

Company Stearns Pet

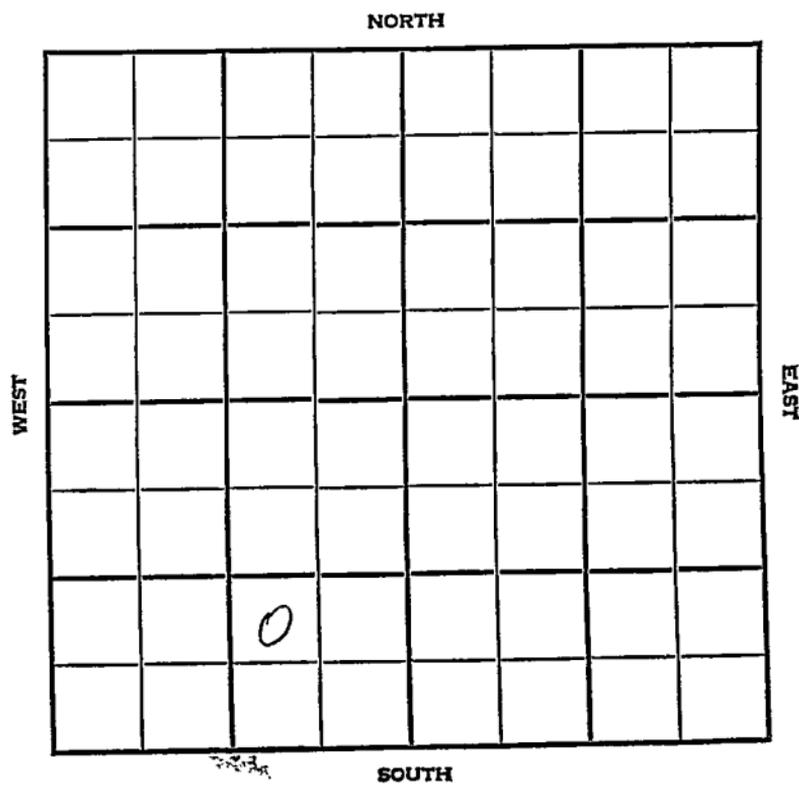

Stafford

KANSAS

SEC.

TWP.

11W

7

22

11W

WELL NO.

#1 Wolf "B"

FARM

COMPANY

Stearns Petr.

CONTRACTOR

Co. Tools

Max Pool


\_\_\_\_\_ FT. FROM N. LINE

\_\_\_\_\_ FT. FROM S. LINE

\_\_\_\_\_ FT. FROM E. LINE

\_\_\_\_\_ FT. FROM W. LINE

NW SE SW

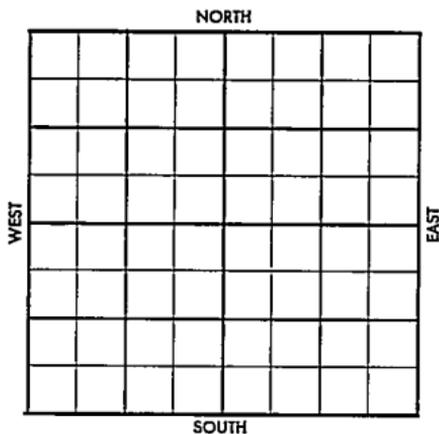

1956

ELEVATION

# # 1810'

REPORT

5-29

MIR

7-3

Comm. 6-16-56

8 5/8" @ 202

DST 3633-42 op 1 hr., 15' socm, 0/30".

D & A

Anh. 550', BL. 3231'; L. 3255';

C. 3505'; V. 3531'; S. 3558';

A. 3634';

TD 3665'

ABANDONED

County Stafford Elev. \_\_\_\_\_  
 Sec. 7 Twp. 22 Rgs. 11W  
 Company Stearns Pet.  
 Farm Name Wolf "B" No. 1

TOPS	DEPTH	LOG	DATUM
Anh.			
TP.			
H.			
Tr.			
Dg.			
Bl.			
L.			
K.C.			
B.K.C.			
Ce.			
C.			
M.			
M.			
K.			
Mz.			
Mo.			
V.			
S.			
S.			
A.			
R.			
PE.			
G.			
T.B.			

Loc. in Sec. NW SE SW

Geol. \_\_\_\_\_

Contr. \_\_\_\_\_

Co. tools \_\_\_\_\_

Pool \_\_\_\_\_

Max Pool \_\_\_\_\_

MAY 29 1955	
FIRST REPORT	
o	

Date Comm. M I R

*[Handwritten scribbles and signatures]*

Co.  
Lse.  
No.  
Sec.  
T.  
R.

County Stafford Elev. 1810  
 Sec. 7 Twp. 22 Rge. IIW  
 Company Stearns Pet.  
 FarmName Wolf "B" No. 1

TOPS	DEPTH	LOG	DATUM
Anh.	550		
Tr.			
H.			
Tr.			
Dg.			
Bl.	3231		
L.	3255		
K.C.			
B.K.C.			
Ce.			
C.	3505		
M.			
M.			
K.			
Mz.			
Me.			
V.	3531		
S.	3558		
S.			
A.	3634		
R.			
PE.			
G.			
TD.	3665		

Loc. in Sec. NW SE SW

Geol. \_\_\_\_\_

Contr. \_\_\_\_\_

Co. tools \_\_\_\_\_

Pool \_\_\_\_\_

Max Pool \_\_\_\_\_

ABANDONED

Date Comm. JUL 3 1956

MIR JUN 6 '56 JUN 13 '56 RUR JUN 20 '56

6-16-56 8 5/8 202. # 1000

JUN 27 '56 DST 3642, JUL 3 '56 DST 3633

-42 1/2 15' 50CM 0/30"

DEA

Cor.

Loc.

No.

Sec.

T.

R.