KANSAS

FORM 51 5M 10-41 PETROL


Stafford

Section 7 Township 22 Range 12-W

Well No. #1 Albers "B"

Company Atlantic Production

Drack pool

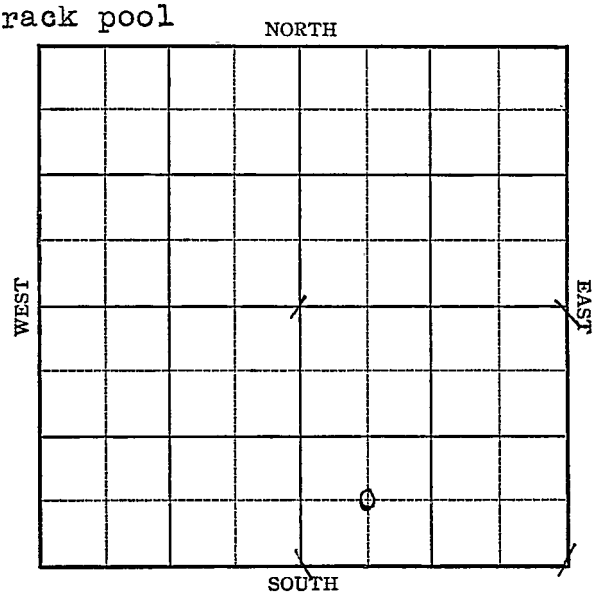

Form 252-A
5M 5-42 Petrol

KANSAS

Stafford

Sec. 7 Twp. 22 R. 12-W

Well No. #1 Albers "B" Farm

Atlantic Production Company


Drack pool

____ Ft. from N. Line

660 Ft. from S. Line

____ Ft. from E. Line

660 Ft. from W. Line

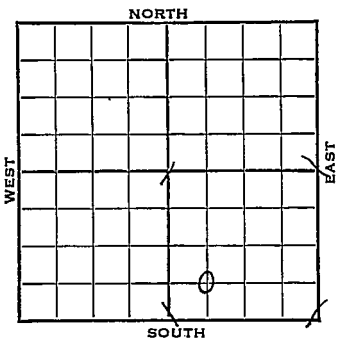

C SW SE Elev. 1880

1942	REPORT
12/2	Rotary
12/9	8" @ 239 Drlg. 2565
12/16	Lans 3336 Congl 3574 Viola 3582 Arb 3679 TD 3682 5" @ 3679 rust.
12/22	" "
12/29	TD 3685 - 2400' oil 24 hrs swab 7 oil per hr. 8 hrs. 1000 acid
1943 1/6	Arb. 3679 5" - 3679 1000 acid Echo Pot. 3924 Max 3000 Gravity 35.7 T.D. 3685

COMPLETED

Form 26 200 Bks 5-42 Petrol

KANSAS

Stafford

Map No. 16 Sec. 7 Twp. 22 R. 12W


Well No. 1 Albers "B"

Atlantic Production Company

FIRST REPORT Contractor

C SW SE

SECTION PLAT

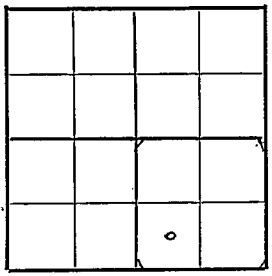

____ Ft. from N. Line

660 Ft. from S. Line

____ Ft. from E. Line

660 Ft. from W. Line

DRACK POOL

Location

Rig up

Drilling and Remarks:

Rotary

RECORD

Cased ____ in., ____ ft.

Sand

Gas

Oil

Total Depth

PRODUCTION

1st 24 hrs. Nat.

1st 24 hrs. after shot

Gas ____ Cu. Ft.

Dry Hole

Abandoned

Date

DEC 2 1942 19

S. J. LEWIS Scout

Form 26 200 Bks 5-42 Petrol

Stafford

KANSAS

Map No. Sec. 7 Twp. 22 R. 12W


Well No. 1 Albers "B"

Atlantic Production Company

COMPLETED Contractor

C S W SE

SECTION PLAT

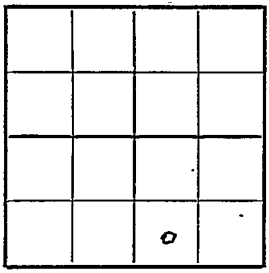

____ Ft. from N. Line

660 Ft. from S. Line

____ Ft. from E. Line

660 Ft. from W. Line

DRACH POOL

Location

Rig up

Drilling and Remarks:

Cu 4367'
5"@ 3679'
1000 Acid
Ec hole 3924
Mud 3000
352 Gr

RECORD

Cased ____ in., ____ ft.

Sand

Gas

Oil

Total Depth 3683'

PRODUCTION

1st 24 hrs. Nat.

1st 24 hrs. after shot

Gas Cu. Ft.

Dry Hole

Abandoned

Date

JAN 6 1943 19

S. J. LEWIS Scout