

KANSAS


Stafford

FORM 51 5M 1-42 PETROL

Section 7 Township 22 Range 12-W

Well No. #4 Alpers

Company Atlantic

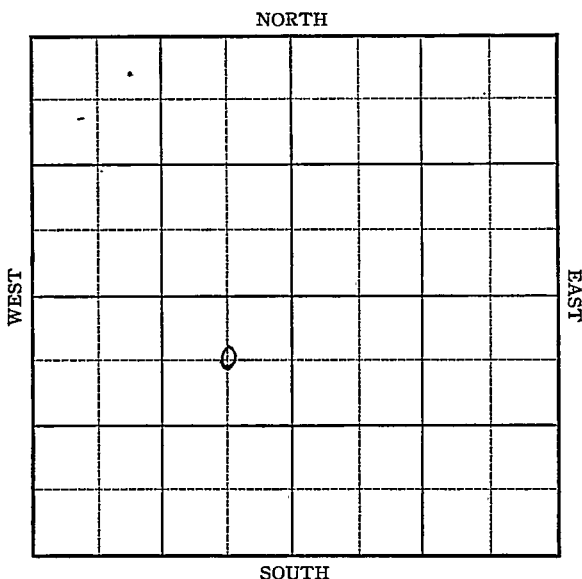


KANSAS

Stafford

Sec. 7 Twp. 22 R. 12-WWell No. #4 Allpers FarmAtlantic Company

Drach

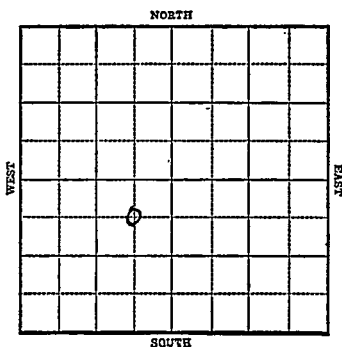660 Ft. from N. Line Ft. from S. Line660 Ft. from E. Line Ft. from W. Line

1943

R E P O R T

4/21 T.D. 232' Run 10"

4/28 10" @ 225'
Drlg. 3028'5/5 Lans 3334
Comgl 3569
Simp 3630
Arb 3668673 T.D.
SO5/12 7" @ 3668' RUST.
" " "5/19 Arb. 3668
7" - 3668
Depth Pot. 8507
Max. 3000
T.D. 3673
Gravity 37.2

COMPLETED

KANSASMap No. 46 Sec. 7 Twp. 22 R. 12WWell No. 4 AlpersAtlantic

Company

FIRST REPORT

Contractor

C N E S W**SECTION PLAT**660 Ft. from N. Line

	0		

 Ft. from S. Line660 Ft. from E. Line Ft. from W. Line**DRACH POOL**Location Rig up

Drilling and Remarks:

T.D. 232'**Run 10"****RECORD**Cased in., ft.Sand Gas Oil Total Depth **PRODUCTION**1st 24 hrs. Nat. 1st 24 hrs. after shot Gas Cu. Ft.Dry Hole Abandoned

Date

APR 21 1943 19S. J. LEWIS Scout

Stafford

KANSAS

Map No. 46 Sec. 7 Twp. 22 R. 12WWell No. 4 AlpersAtlantic

Company

COMPLETED

Contractor

C NE SW

SECTION PLAT

660 Ft. from N. Line Ft. from S. Line660 Ft. from E. Line Ft. from W. Line

	0		

DRACH POOL

Location Rig up

Drilling and Remarks:

Cor 3668
7" @ 3668
Dep 1800 28507
May 3000

37 1/2 Gr

RECORD

Cased in., ft.Sand Gas Oil Total Depth 3673

PRODUCTION

1st 24 hrs. Nat. 1st 24 hrs. after shot Gas Cu. Ft.Dry Hole Abandoned

Date

MAY 19 1943 19

S. J. LEWIS Scout