

KANSAS


FORM 51 5M PETROL

Stafford

Section 7 Township 22 Range 12-W

Well No. #2 Crawford

Company Sinclair Prairie

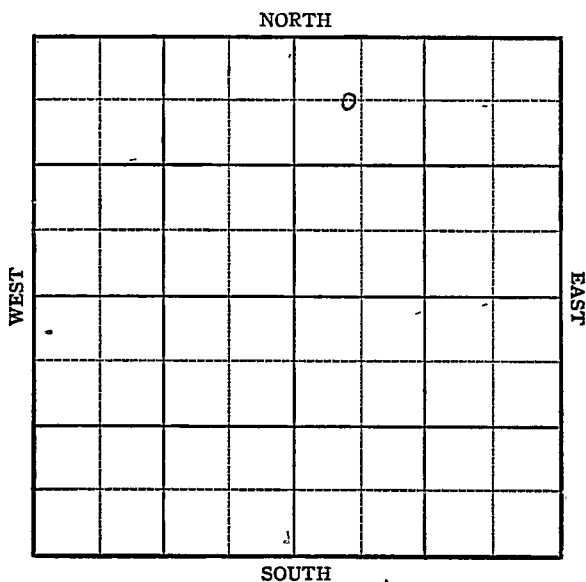


KANSAS

St. afford

Sec. 7 Twp. 22 R. 12-WWell No. #2 Crawford FarmSinclair Prairie Company660 Ft. from N. Line Ft. from S. Line Ft. from E. Line510 Ft. from W. Line

Elev. 1875

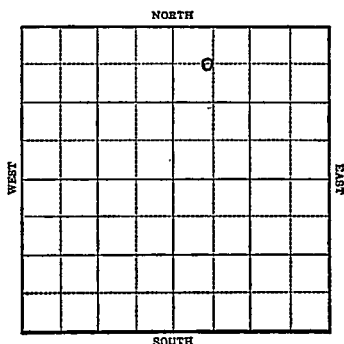

1943

R E P O R T

9/22

Derrick

9/29

Surface hole

10/6

9" @ 289'

Drlg. 1840'

10/13

Drlg. 3330'

10/20

Lans 3320

Viola 3570

Arb 3666-70 T.D.S0

5" @ 3666

Rust.

10/27

"

11/3

Arb 3666

5" @ 3666'

1000. acid

Depth Pot 2234

T.D. 3670'

Gravity 36.8

COMPLETED

KANSAS

Map No. 46 Sec. 7- Twp. 22 R. 12WWell No. 2 CrawfordSinclair Prairie

Company

FIRST REPORT

Contractor

C NW NE

660

Ft. from N. Line

Ft. from S. Line

Ft. from E. Line

510

Ft. from W. Line

SECTION PLAT

		o	

Drech Pool

Location

Rig up

Drilling and Remarks:

Derrick

RECORD

Cased _____ in., _____ ft.

Sand _____

Gas _____

Oil _____

Total Depth _____

PRODUCTION

1st 24 hrs. Nat. _____

1st 24 hrs. after shot _____

Gas _____ Cu. Ft.

Dry Hole _____

Abandoned _____

Date

SEP 22 1943

19

S. J. LEWIS

Scout.

KANSAS

Map No. 46 Sec. 7 Twp. 22 R. 12W

Well No. 2 Crawford

Sinclair Prairie Company

COMPLETED Contractor

C NW NE

660 Ft. from N. Line

Ft. from S. Line

Ft. from E. Line

510 Ft. from W. Line

SECTION PLAT

		o	

Drach Pool

Location _____

Rig up _____

Drilling and Remarks:

Cr 48666

5" Cr 48666

1000 Seal

Sept 11 1943 2234

365 ft

RECORD

Cased _____ in., _____ ft.

Sand _____

Gas _____

Oil _____

Total Depth 3670

PRODUCTION

1st 24 hrs. Nat. _____

1st 24 hrs. after shot _____

Gas _____ Cu. Ft.

Dry Hole _____

Abandoned _____

Date

NOV 3 1943 19

S. J. LEWIS Scout