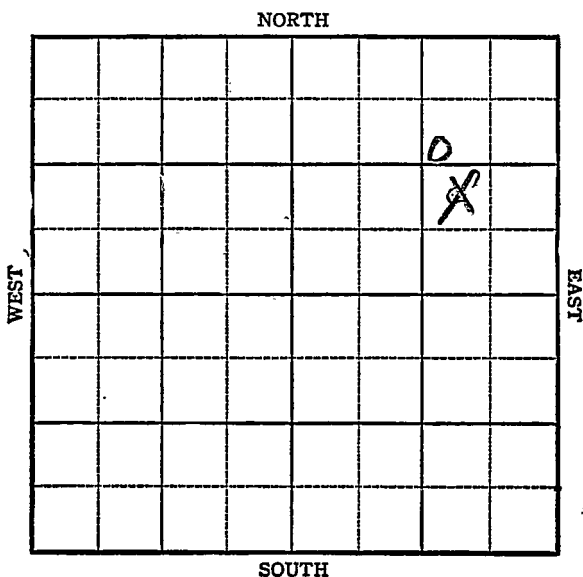


KANSAS

Section 7 Township 22 Range 12WWell No. 4 CrawfordCompany Sinclair-Prairie

KANSAS

Stafford County

Sec. 7 Twp. 122nd R. 12W

Well No. #4 Crawford Farm

Sinclair-Prairie Company

Sittner

NORTH

990 Ft. from N. Line

 Ft. from S. Line

990 Ft. from E. Line

 Ft. from W. Line

WEST

EAST

SW NE NE

6 lev. 1874 SOUTH

1944

REPORT

8/30
9/8

Rotary
9" @ 286 Drlg. 1960

9/13
9/21

Drlg. 3160
Lans 3335
Viola 3576
Simp 3617
Arb 3672
TD 3673
5" @ 3672 RUST

9/28
10/4

1500 acid swb 35 oil per hr
Arb 3672
5" @ 3672
1500 acid
Pump 1265 Pot.
TD 3673
Grav. 39.

COMPLETED

KANSAS Pool Name Sittner
 Map No. 46 Sec. 7 Twp. 22 R. 12W
 Well No. 4 Crawford

Sinclair-Prairie Company

FIRST REPORT

Contractor

SW NE NE

SECTION PLAT

			o

990 Ft. from N. Line Ft. from S. Line990 Ft. from E. Line Ft. from W. Line

Stafford

Location Rig up

Drilling and Remarks:

Rotary

RECORD

Cased in., ft.Sand Gas Oil Total Depth

PRODUCTION

1st 24 hrs. Nat. 1st 24 hrs. after shot Gas Cu. Ft.Dry Hole Abandoned

Date

AUG 30 1944 19

S. J. LEWIS Scout

Pool Name SittnerMap No. 46 Sec. 7 Twp. 22 R. 12WWell No. 4 CrawfordSinclair-Prairie

Company

COMPLETED

Contractor

SW NE NE

SECTION PLAT

990

Ft. from N. Line

Ft. from S. Line

990

Ft. from E. Line

Ft. from W. Line

			o
.			

Stafford County

Location

Rig up

Drilling and Remarks:

Cr. 86725" @ 86721500 acdPump 1265 P.X29° SW

RECORD

Cased _____ in., _____ ft.

Sand _____

Gas _____

Oil _____

Total Depth 3673

PRODUCTION

1st 24 hrs. Nat. _____

1st 24 hrs. after shot _____

Gas _____ Cu. Ft.

Dry Hole _____

Abandoned _____

Date

OCT 4 1944

19

S. J. LEWIS

Scout