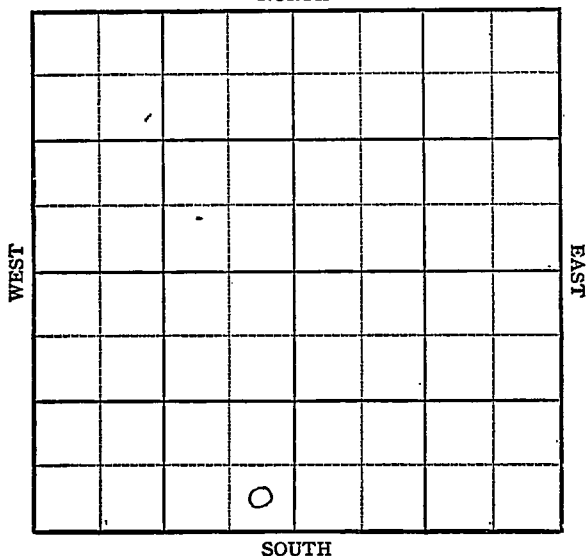


KANSAS Stafford

Section 7 Township 22 Range 12WWell No. 2 AlbersCompany AtlanticBrock Pool
NORTH

Sec. 7 Twp. 22 R. 12W ✓

Well No. 2 Albers Farm

Atlantic Company

Brock Pool


 Ft. from N. Line

330 Ft. from S. Line

268 Ft. from E. Line

 Ft. from W. Line

SE SW

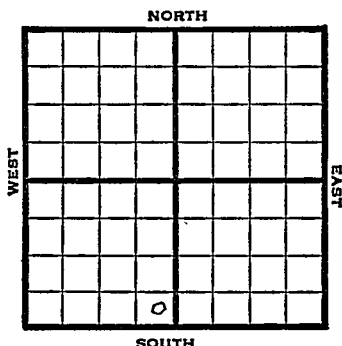

1948 Eli 1879' REPORT

8/25	8" @ 291'
	Drlg. 370'
9/1	Drlg. 2775'
9/8	Lansing 3328'
	Viola 3582'
	Simpson 3616'
	Arbuckle 3669'
	TD 3672'
	5" @ 3670'
9/14	"
9/21	TD 3673'
	1000 acid swb 40 bbls oil PH -
	2 hrs.
9/29	"
10/6	"
10/13	"
10/20	TD 3673'
	Arb. 3669'
	5"@ 3670'
	1000 acid
	Pump 145 Oil / 50% W Pot
	39° Gr.
	Comp

COMPLETED

Map No. 46 Sec. 7 Twp. 22 R. 12W

Well No. 2 Albers

Atlantic


Company

COMPLETE

Contractor

SE SW

E. 11879
SECTION PLAT

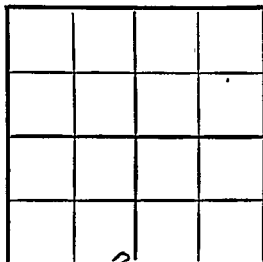

 Ft. from N. Line

330 Ft. from S. Line

288 Ft. from E. Line

 Ft. from W. Line

Stafford County

Location

Rig up

Drilling and Remarks:

Dr x 3669
5" @ 3670
1000 acid
Run 145 oil +
50% N/P & T
3924

RECORD

Cased in., ft.

Sand

Gas

Oil

Total Depth 3673

PRODUCTION

1st 24 hrs. Nat.

1st 24 hrs. after shot

Gas Cu. Ft.

Dry Hole

Abandoned

Date

OCT 20 1948

S. J. LEWIS Scout