

KANSAS


Stafford

FORM 51 5M 1-42 PETROL

Section 7 Township 22 Range 12 ~~W~~

Well No. #1 Cora Crawford

Company Sinclair-Prairie

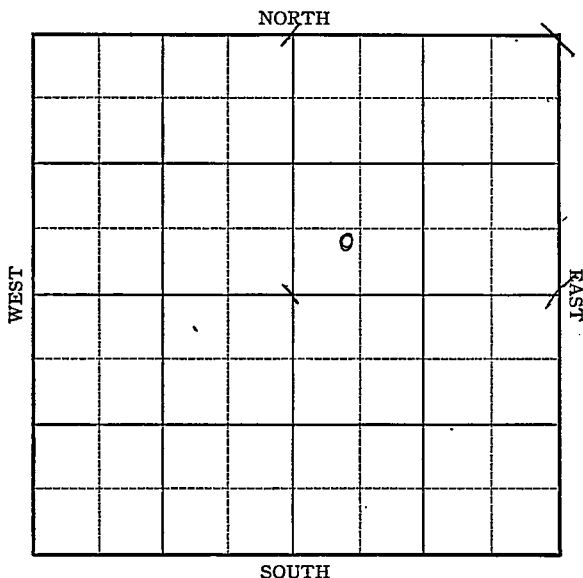

KANSAS

Stafford

Sec. 7 Twp. 22 R. 12-W

Well No. #1 Cora Crawford Farm

Sinclair-Prairie Company

Drach


 Ft. from N. Line

530 Ft. from S. Line

 Ft. from E. Line

585 Ft. from W. Line

Elev. 1872

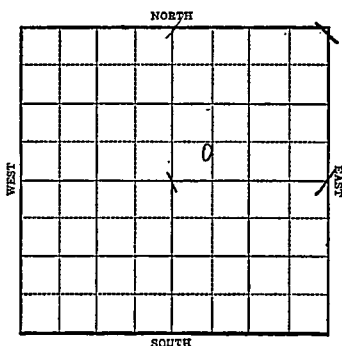


1943

R E P O R T

7/7	Location.
7/15	9" @ 282'
	Drlg. 1620'
7/21	Lans 3315
	Drlg. 3520
7/28	Cong 3565
	Viola 3578
	Arb 3663
	T.D. 3670
	5" @ 3665
	RUST SO
8/4	2710' oil in 10 hrs.
8/11	Arb 3663
	5" @ 3665
	1000 acid
	Depth Pot. 2790' oil T 210
	water.
	T.D. 3670'
	Gravity 37

COMPLETED

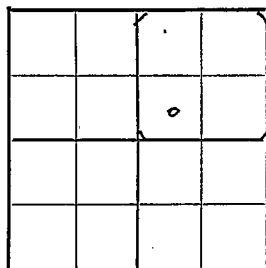KANSASMap No. 46 Sec. 7 Twp. 22 R. 12WWell No. 1 Cora CrawfordSinclair-Prairie CompanyFIRST REPORT Contractor**C SW NE****SECTION PLAT** Ft. from N. Line530 Ft. from S. Line Ft. from E. Line585 Ft. from W. Line**DRACH POOL**Location XXXXRig up

Drilling and Remarks:

RECORDCased in., ft.Sand Gas Oil Total Depth **PRODUCTION**1st 24 hrs. Nat. 1st 24 hrs. after shot Gas Cu. Ft.Dry Hole Abandoned

Date

JUL 7 1943₁₉**S. J. LEWIS** Scout

KANSAS
 Map No. 7 Sec. 7 Twp. 22 R. 12W

Well No. 1 Cora Crawford

Sinclair-Prairie Company

COMPLETED Contractor

C SW NE

SECTION PLAT

 Ft. from N. Line

530 Ft. from S. Line

 Ft. from E. Line

585 Ft. from W. Line

DRACH P OOL

Location

Rig up

Drilling and Remarks:

*Ar 73663
 5" @ 3665
 1000 and C
 Sep 10 Po 82790 oil
 7210 Water.*

37 1/2 gr

RECORD

Cased in., ft.

Sand

Gas

Oil

Total Depth 3670

PRODUCTION

1st 24 hrs. Nat.

1st 24 hrs. after shot

Gas Cu. Ft.

Dry Hole

Abandoned

Date

AUG 11 1943 19

S. J. LEWIS Scout