

KANSAS


FORM 51 5M 1-42 PETROL

Stafford

Section 7 Township 22 Range 12-W

Well No. #3-Hitz

Company Phillips

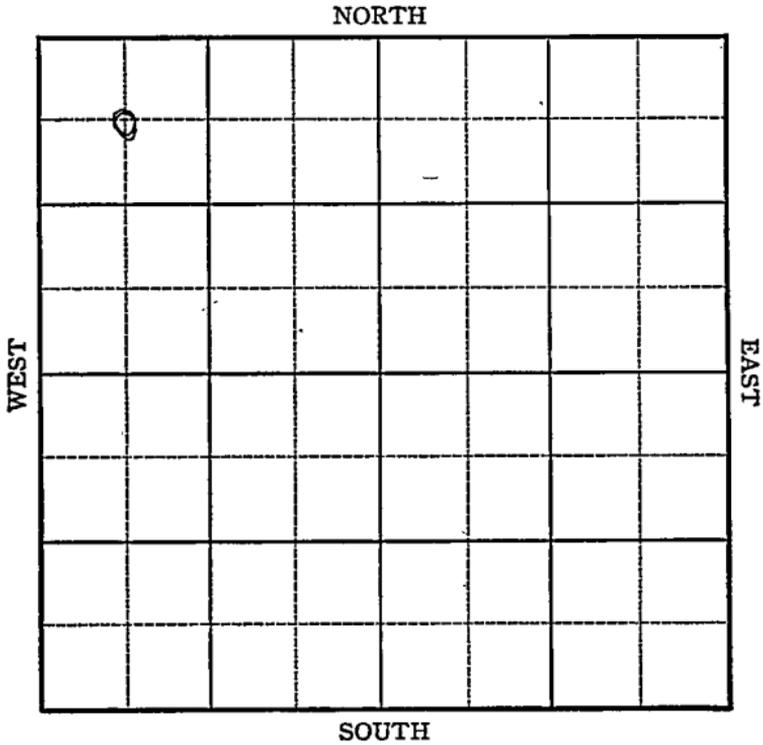

Sec. 7 Twp. 22 R. 12-W

Well No. #3 Hitz Farm

Phillips Company


Drach

660 Ft. from N. Line

_____ Ft. from S. Line

_____ Ft. from E. Line

660 Ft. from W. Line

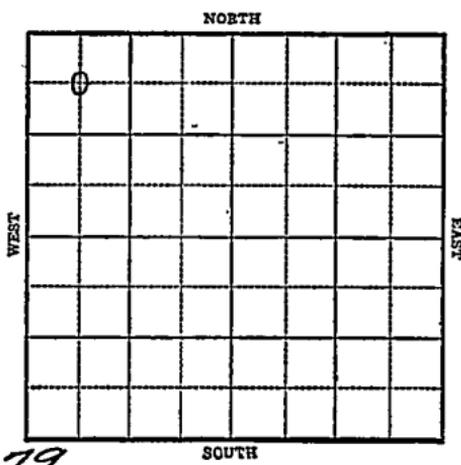

Elev. 1879

1943

R E P O R T

- 7/14 Drlg. 159'
- 7/21 Drlg. 2935'
- 7/28 Mans 3334
Viola 3572
Arb 3666
T.D. 3670
- 8/4 5" @ 3666 Rust SO
1400' oil 4½ hrs.
- 8/11 " " "
- 8/18 Arb 3666
5" @ 3666
Pump 674 Pot.
T.D. 3670'
Grav. 37

COMPLETED

Stafford

~~KANSAS~~
 Map No. _____ Sec. 7 Twp. 22 R. 12W

Well No. 3 HitzPhillips

Company

FIRST REPORT

Contractor

C NW NW

SECTION PLAT

660 Ft. from N. Line

_____ Ft. from S. Line

_____ Ft. from E. Line

660 Ft. from W. Line

0			

DRACH POOL

Location _____

Rig up _____

Drilling and Remarks:

Drlg. 159'

RECORD

Cased _____ in., _____ ft.

Sand _____

Gas _____

Oil _____

Total Depth _____

PRODUCTION

1st 24 hrs. Nat. _____

1st 24 hrs. after shot _____

Gas _____ Cu. Ft.

Dry Hole _____

Abandoned _____

Date

JUL 14 1943 19

S. J. LEWIS Scout

KANSAS
 Map No. 46 Sec. 7 Twp. 22 R. 12W

Well No. 3 Hit z

Phillips Company

COMPLETED Contractor

C NW NW

SECTION PLAT

660 Ft. from N. Line

_____ Ft. from S. Line

_____ Ft. from E. Line

660 Ft. from W. Line

o			

DRACH POOL

Location _____

Rig up _____

Drilling and Remarks:

Ar 73666

5" @ 3666

Pump 674000

87 1/2

RECORD

Cased _____ in., _____ ft.

Sand _____

Gas _____

Oil _____

Total Depth 2670

PRODUCTION

1st 24 hrs. Nat. _____

1st 24 hrs. after shot _____

Gas _____ Cu. Ft.

Dry Hole _____

Abandoned _____

Date

AUG 18 1943

19

S. J. LEWIS Scout.