


Section 7 Township 22 Range 12-W


Well No. #4 Hitz

Company Phillips

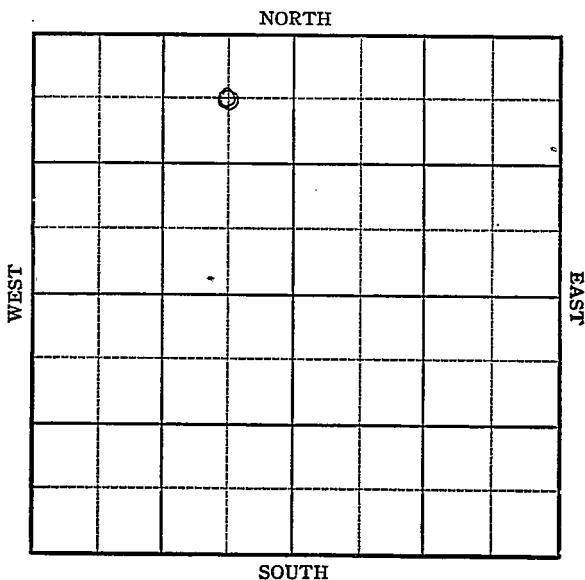

KANSAS

Stafford

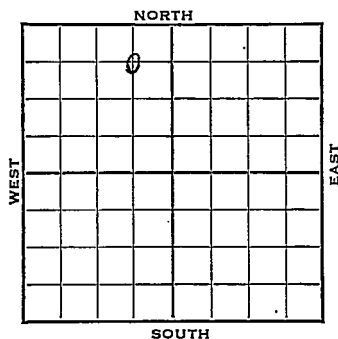Sec. 7 Twp. 22 R. 12-WWell No. #4 Hitz FarmPhillips Company660 Ft. from N. Line Ft. from S. Line660 Ft. from E. Line Ft. from W. Line

1943

Elev. 1874 REPORT

8/25

Location

9/1

8" @ 388
Drlg. 450'

9/8

Drlg. 3520

9/15

Arb 3655-57 T.D.
5" @ 3655'
Rust

9/22

T.D. 3662'
3400' oil in 3 hrs.

9/29

2000 acid
Testing.

10/6

Arb 3655
5" @ 3655
2000 acid
Pump 1253 Pot.
Gravity 39.3
T.D. 3662'

COMPLETED

KANSAS

Map No. 46 Sec. 7 Twp. 22 R. 12WWell No. 4 HitzPhillips

Company

FIRST REPORT

Contractor

C NE NW

660 Ft. from N. Line Ft. from S. Line660 Ft. from E. Line Ft. from W. Line

SECTION PLAT

	o.		

Drach Pool

Location XRig up

Drilling and Remarks:

RECORD

Cased in., ft.Sand Gas Oil Total Depth

PRODUCTION

1st 24 hrs. Nat. 1st 24 hrs. after shot Gas Cu. Ft.Dry Hole Abandoned

Date

AUG 25 1943

19

S. J. LEWIS

Scout

KANSASMap No. 46 Sec. 7 Twp. 22 R. 12WWell No. 4 HitzPhillips

Company

COMPLETED

Contractor

C NE NW**SECTION PLAT**660 Ft. from N. Line

Ft. from S. Line

660 Ft. from E. Line

Ft. from W. Line

	0		

Drach Pool

Location

Rig up

Drilling and Remarks:

Ar 83655
5" @ 3655
2000 acid
Pump 1250 RY

*39² 1/2***RECORD**

Cased _____ in., _____ ft.

Sand _____

Gas _____

Oil _____

Total Depth 3662**PRODUCTION**

1st 24 hrs. Nat. _____

1st 24 hrs. after shot _____

Gas _____ Cu. Ft.

Dry Hole _____

Abandoned _____

Date

OCT 6 1943

19

S. J. LEWIS Scout