


KANSAS

Form 51-5M-11-31-1 Palace

Map No. _____ Sec. 7 Twp. 22 R. 3WWell No. 1 - Frouse Farm _____
Empire Company

NORTH

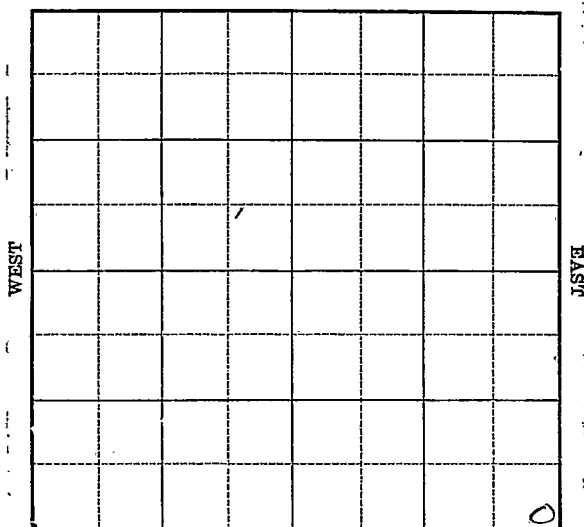

SOUTH

O. W. D. D

Location _____

Drilling Remarks _____

Rig Up _____

Drilling Remarks _____

RECORD

Cased _____ in. _____ ft.

Sand _____

Gas _____

Oil _____

Total Depth _____

PRODUCTION

1st 24 hrs. Nat. _____

1st 24 hrs. after shot _____

Gas _____ cu. ft.

Dry Hole _____

Abandoned _____

KANSAS

Map No. _____ Sec. 7 Twp. 22 R. 3W

Well No. 1- Froese Farm _____


Empire Company _____

_____ Ft. from N. Line

330 Ft. from S. Line

330 Ft. from E. Line

_____ Ft. from W. Line

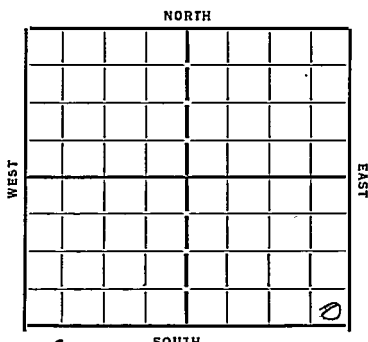

Special

Date	REPORT	O. W. D. D
1933		
8/2	Cellar	
8/9	Rig	
8/17	—	
8/23	15" 326 dily 330'	
8/30	2410 S.D.	
9/6	T.D. 2450 - Re-cem sur pipe	
9/13	hereg 2500'	
9/20	Top Chat 3121 Coring 3178'	
9/29	T.D. 3245	
10/5	Huntow 3359-98 - T.D. 3409 Haliburnton test 3361-3409 small show air & salt water	
10/11	T. Urea 3512 - T.D. 3519 - fishing	
10/18	—	
10/25	6" at 3517 - T.D. 3525 - u.o.c.	
11/1	Top Simpson 3529	
	" Welcox 3532	
	T.D. 3555	
	swab 30 bbls per hr - 6 hrs.	
11/8	—	
11/15	Top Wilson 3532 T.D. 3555	
	847 bbls	
	COMPLETED	

(OVER)

1935 O. W. D. D

10/2 Sil 3598 - 3607 T7
Swab 100 Bbls 8 hrs.

10/9 Sil 3598
T7 3607
51 Bbls.

COMPLETED

Map No. 43 Sec. 7 Twp. 22 R. 3W

Well No. #1 - Throese

Empire Company

Contractor

SPECIAL

Ft. from N. Line


330 Ft. from S. Line

330 Ft. from E. Line

Ft. from W. Line

FIRST REPORTS

SECTION PLAT

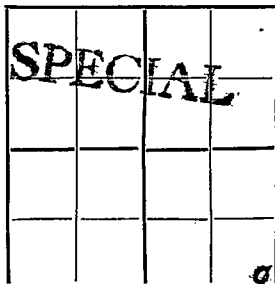

Location

Rig up

Drilling and Remarks:

cellar

RECORD

Cased _____ in., _____ ft.

Sand _____

Gas _____

Oil _____

Total Depth _____

PRODUCTION

1st 24 hrs. Nat. _____

1st 24 hrs. after shot _____

Gas _____ Cu. Ft.

Dry Hole _____

Abandoned _____

Date

8/2/33

192

Oswald Mammisch Scout

Map No. 43 Sec. 7 Twp. 22 R. 3WWell No. 1- FrouseEmpire CompanySPECIAL Contractor**COMPLETED**

SECTION PLAT

.....Ft. from N. Line

330 Ft. from S. Line330 Ft. from E. Line

.....Ft. from W. Line

Location.....

Rig up.....

Drilling and Remarks:

847 bbls

RECORD

Cased.....in.,.....ft.

Sand Will not 3532

Gas.....

Oil.....

Total Depth 3555

PRODUCTION

1st 24 hrs. Nat.....

1st 24 hrs. after shot.....

Gas.....Cu. Ft.

Dry Hole.....

Abandoned.....

Date

11-15-33 192 P. Maunshreck Scout

Map No. 43 Sec. 7 Twp. 22 R. 34Well No. 1 - P. roseEmpire oil Company

Contractor

TEST REPORTS

SECTION PLAT

Ft. from N. Line

330 Ft. from S. Line330 Ft. from E. Line

Ft. from W. Line

			0

Quid

Location

Rig up

Drilling and Remarks:

3560 OTNSil 3598-3607
Swab 100 bbls
8 hrs.

RECORD

Cased.....in.,ft.

Sand.....

Gas.....

Oil.....

Total Depth.....

PRODUCTION

1st 24 hrs. Nat.....

1st 24 hrs. after shot.....

Gas.....Cu. Ft.

Dry Hole.....

Abandoned.....

Date

ORVAL MANNSCHRECK

10-2-35 192

Scout

Map No. 43 Sec. 7 Twp. 22 R. 3 N

Well No. 1 - Frouse

Empire oil Company

Contractor

COMPLETED

SECTION PLAT

Ft. from N. Line

330 Ft. from S. Line

330 Ft. from E. Line

Ft. from W. Line

Card

Location

Rig up

Drilling and Remarks:

51 bbls

RECORD

Cased in. ft.

Sand SD 3598

Gas

Oil

Total Depth 3607

PRODUCTION

1st 24 hrs. Nat.

1st 24 hrs. after shot

Gas Cu. Ft.

Dry Hole

Abandoned

Date

10-9-38 192 ORVAL MANSCHRECK Scout