

Harvey

Map No. **KANSAS** Sec. 7 Twp. 22 R. 3W


Well No. 2 Groese Farm
Empire Company

 Ft. from N. Line

986 Ft. from S. Line

335 Ft. from E. Line

 Ft. from W. Line

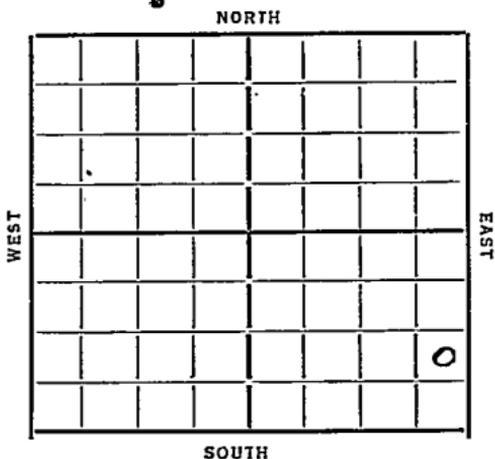

Date	REPORT
1934	
3/7	Location
3/15	Moving in
3/22	Rig
3/29	<u> </u>
4/5	Dlg 690
4/12	<u> </u>
4/19	Dlg 2635
4/26	Dlg 3270 Chat 3145
5/3	B.L. 3292 Denton 3390
	TD 3396 8'4 3393 Rust
5/10	Railing
5/18	TD 3436 5.0. 1000 gal acid
5/25	Pump 96 bbls 24 hrs.
5/31	1000 gal Run tubing
6/7	Pump 175 oil 24 hrs
	Dlg 3455
6/14	" 3513
6/27	Wilcox 3539 TD 3560
	277 oil 35 water.

COMPLETED

Map No. 43 Sec. 7 Twp. 22 R. 3W

Well No. 2 Phoenix

Empire Company

Contractor

FIRST REPORTS

SECTION PLAT

..... Ft. from N. Line

986 Ft. from S. Line

335 Ft. from E. Line

..... Ft. from W. Line

			0

Location

Rig up

Drilling and Remarks:

RECORD

Cased..... in., ft.

Sand.....

Gas.....

Oil.....

Total Depth.....

PRODUCTION

1st 24 hrs. Nat.....

1st 24 hrs. after shot.....

Gas..... Cu. Ft.

Dry Hole.....

Abandoned.....

Date

3-7-34 192 O. Mansfield Scout

Map No. 43 Sec. 7 Twp. 22 R. 3W

Well No. 2 - Throuse
Empire Oil Company
Contractor

COMPLETED

SECTION PLAT

			0

Ft. from N. Line
986 Ft. from S. Line
335 Ft. from E. Line
Ft. from W. Line

Location _____
Rig up _____
Drilling and Remarks:

RECORD

Cased _____ in., _____ ft.
Sand 3539
Gas _____
Oil _____
Total Depth 3560

PRODUCTION

1st 24 hrs. Nat. _____
1st 24 hrs. after shot _____
Gas _____ Cu. Ft.
Dry Hole _____
Abandoned _____

277 oil
35 water

Date 6-27-37

ORVAL MANNSCHRECK
Scout