

Section 8 Township 22 Range 13-WWell No. #1 SchmdtCompany Sterling Drig.

Wildcat

NORTH

WEST

EAST

				0			

SOUTH

KANSAS

Stafford

✓

Sec. 8 Twp. 22 R. 13W

Well No. #1 Schmidt Farm

Sterling Drlg. Company

Wildcat


330' Ft. from N. Line

_____ Ft. from S. Line

_____ Ft. from E. Line

330' Ft. from W. Line

NW NE

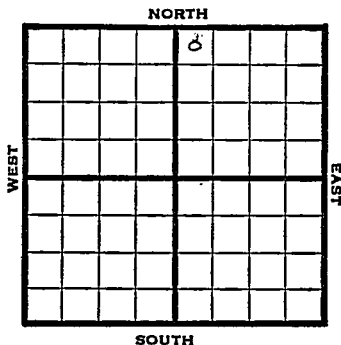

1948

Eli 1905'

REPORT

6/23

RUR

6/29

8"@ 280'

Drlg 1975'

7/14

TD 3820'

Viola 3685'

Simpson 3728'

Arb. 3782'

Abandoned

ABANDONED

Map No. _____ Sec. 8 Twp. 22 R. 13W

Well No. 1 Schmidt

Sterling Drlg. Company

FIRST REPORT Contractor

NW NE

SECTION PLAT

		4	

330 Ft. from N. Line

_____ Ft. from S. Line

_____ Ft. from E. Line

330 Ft. from W. Line

Stafford County

Location _____

Rig up _____

Drilling and Remarks:

R U R

RECORD

Cased _____ in., _____ ft.

Sand _____

Gas _____

Oil _____

Total Depth _____

PRODUCTION

1st 24 hrs. Nat. _____

1st 24 hrs. after shot _____

Gas _____ Cu. Ft.

Dry Hole _____

Abandoned _____

Date

JUN 23 1948 19 S. J. LEWIS Scout

Map No. 82 Sec. 8 Twp. 22 R. 13WWell No. 1 Schmidt

Sterling Drlg. Company

ABANDONED


Contractor

NW NE

E11905
SECTION PLAT330 Ft. from N. Line

Ft. from S. Line

Ft. from E. Line

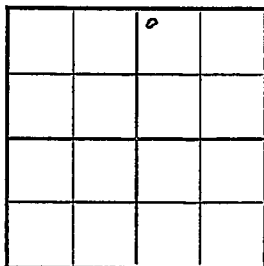330 Ft. from W. Line

Stafford County

Location

Rig up

Drilling and Remarks:

Viola 8685Snip 8728Gr 43782

RECORD

Cased _____ in., _____ ft.

Sand _____

Gas _____

Oil _____

Total Depth 3820

PRODUCTION

1st 24 hrs. Nat. _____

1st 24 hrs. after shot _____

Gas _____ Cu. Ft.

Dry Hole _____

Abandoned _____

Date

JUL 14 1948

19

S. I. LEWIS Scout