


Section 8 Township 22 Range 13W

Well No. #1 Garvin

Company Vickers

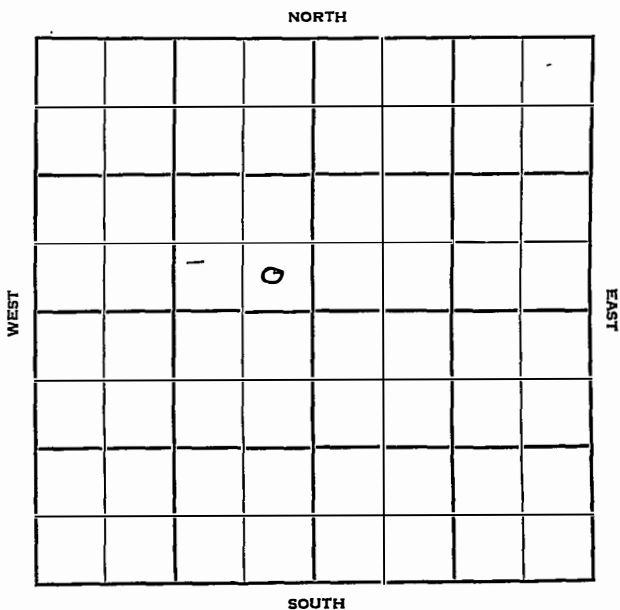

Stafford KANSAS

Sec. 8 Twp. 22 R. 13 W

Well No. # 1 Garvin Farm

Vickers Company.

Wildcat Contractor


Ft. from N. Line

330 Ft. from S. Line

330 Ft. from E. Line

Ft. from W. Line

SE SE NW

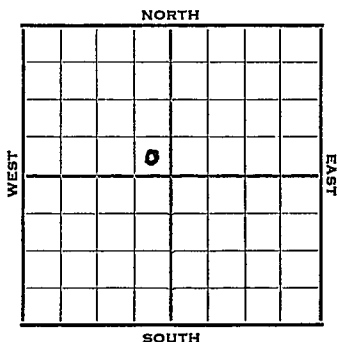

1952 Elev. 1909' REPORT

9/17 Location

9/24 8" @ 310

10/1 Heeb. 3280'

Drlg. 3300'

10/8 Spud 9-22-52

D & A TD 3835' 8" @ 310

Heeb 3280' Tor. 3299'

Br. lime 3409' Lans. 3420'

B KC 3655' Cong. 3673' Ch. Viola

3711' Simp. 3754' Arb. 3814'

TD 3835' D & A

ABANDONED

County Stafford State Kansas
 Sec. 8 (Blk. 22 (Sur. 13W Map No.
 (Twp.) (Rge.)

Operator Vickers

Well No. 1 Farm Garvin

Elev. _____ Location SE SE NW

FIRST REPORT

330 Ft. From S Line NW

330 Ft. From E Line Quarter

Ist. Report SEP 17 1952

Completion _____

Remarks _____


Spudding Date _____

Drlg. Data _____

Wildcat

Location

J. G. McGEHEE

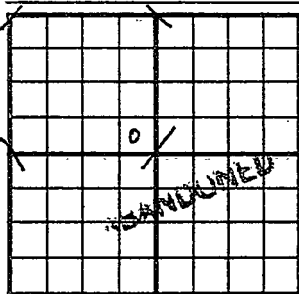County Stafford State KansasSec. 8 (Blk.
Twp.) 22 (Sur.
Rge.) 13W Map No.Operator Vickers Pet.Well No. 1 Farm GarvinElev. 1909 Location SE SE NW330 Ft. From S Line NW330 Ft. From E Line Quarter

1st. Report

Completion OCT 8 1952Remarks WildcatSpudding Date 9-22-52Drilg. Data D & A TD 38358" @ 310 Heeb. 3280 Tor. 3299Br. lime 3409 Lans. 3420 B KC 3655Cong. 3673 Ch. Viola 3711 Simp. 3754Arb. 3814 TD 3835D & A