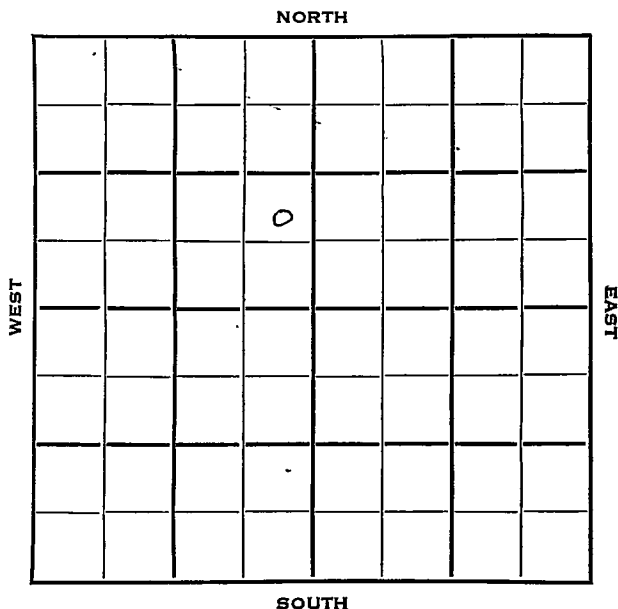


Stafford

KANSAS

Section 8 Township 22 Range 11WWell No. 1 - StandishCompany Petroleum Inc.

Stafford

KANSAS ✓

8

22

14W

Sec. _____ Twp. _____ R. _____

Well No. #1 Standish _____ Farm _____

Petroleu, Inc. _____ Company _____

Garvey _____ Contractor _____

N. Strobble Pool

_____ Ft. from N. Line


990 _____ Ft. from S. Line

330 _____ Ft. from E. Line

_____ Ft. from W. Line

NE SE NW

3

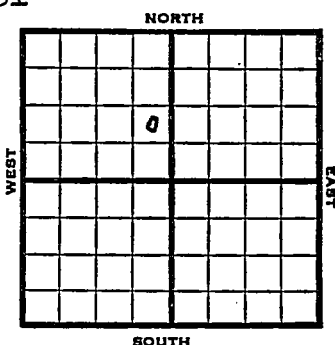

1953

Elev. 1951' REPORT

1/14

Spud 1-8-53
 8" @ 221'
 Anhy 890'
 Drlg. 2385'

1/23

Spud 1-8-53
 D & A TD 3917' 8" @ 221
 Anhy 890' Heeb 3343' Br. line
 3463' Lans. 3474' Cong. 3770'
 Viola 3779' Simp. 3845'
 DST 3770-3846' open 40 min rec 15'
 mud.
 TD 3917' D & A


ABANDONED

County Stafford State Kansas
 Sec. 8 (Blk.) 22 (Sur.) 14W Map No.

Operator Petroleum Inc.

Well No. 1 Farm Standish

Elev. Location NE SE NW

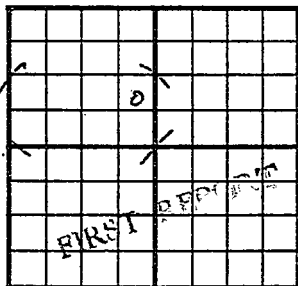

990 Ft. From S Line NW

330 Ft. From E Line Quarter

1st. Report JAN 14 1953

Completion

Remarks


Garvey - Contr.

Spudding Date 1-8-53

Drlg. Data N. Strobe Pool

8" @ 221 Anhy 890 drlg. 2385

J. G. McGEHEE

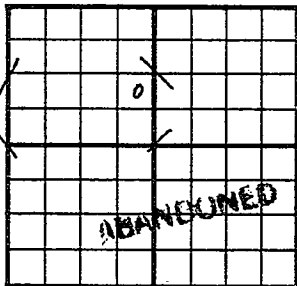County Stafford State KansasSec. 8 (Blk.) 22 (Sur.) 14W Map No.Operator Petroleum Inc.Well No. 1 Farm StandishElev. 1951 Location NE SE NW990 Ft. From S Line NW330 Ft. From E Line Quarter1st. ReportCompletion JAN 23 1953Remarks N. Stroble PoolGarvey - Contr.Spudding Date 1-8-53Drlg. Data D & A TD 39178" @ 221 Anhy 890 Heeb. 3343Br. lime 3463 Lans. 3474 Cong. 3770Viola 3779 Simp. 3845 DST 3770-3846open 40 min. Rec. 15' mud TD 3917D & A

J. G. McGEHEE