
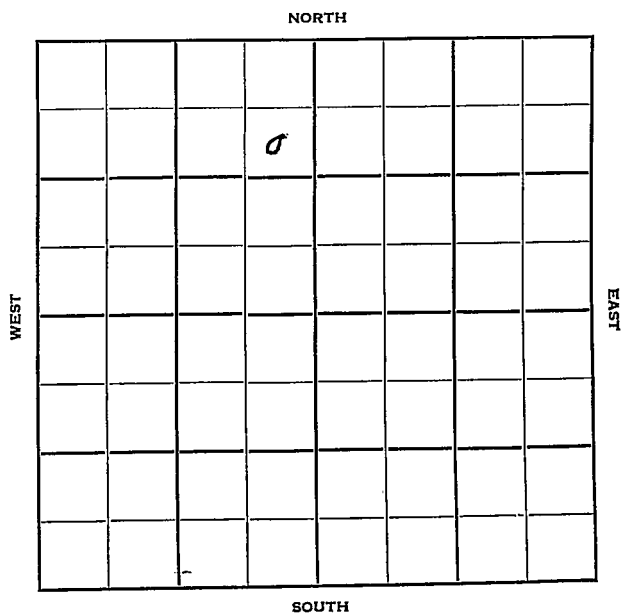


KANSASSection 8 Township 22 Range 14WWell No. #1 Stroble (C)Company Petroleum, Inc.

Stafford KANSAS ✓

Sec. 8 Twp. 22 R. 14 WWell No. # 1 Stroble (C) FarmPetroleum Inc. CompanyGarvie Contractor990 Ft. from N. Line Ft. from S. Line330 Ft. from E. Line Ft. from W. Line

SE NE NW

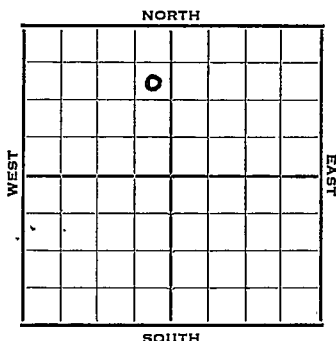


1952 Elev. 1952' REPORT

7/16 Spud 7-13-52
8" @ 225 WOC7/23 Anhy 878 Heeb. 3339
Lans. 3479
DST 3595-3610 1/2 hr. 8' m
Drlg. 36777/30 Cong. 3773 V 3778
Simp. 3831 Simp sd 3852-60
Arb. 3887
RTD 3893 5" @ 38898/6 CO 6/3852-53 S/3 BOPH 6/3853-54
S/4 BOPH

8/13 NR

8/20 "

8/27 Spud 7-13-52
Oil Well TD 3893 8" @ 225
Anhy 878 Heeb. 3339
Lans. 3479 Cong. 3773
Viola 3778 Simp. 3831
Simp sd 3852
DST 3854-61 open 1 hr. rec. 305' free
oil 60' ocm 1475# Arb. 3887
DST 3888-93 open 1 hr. rec. 30' mud
800# TD 3893 5" @ 3899 t/ 3852-53
S/ 3 boph 6/ 3853-54 S/ 4 boph
Comp. 94 bopd**COMPLETED**

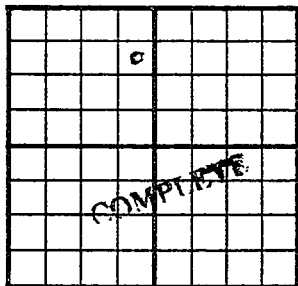County Stafford State KansasSec. 8 (Blk. 22) (Sur. 14W) Map No.Operator Petroleum Inc.Well No. 1 Farm Stroble "C"Elev. 1952 Location SE NE NW990 Ft. From N Line NW330 Ft. From E Line Quarter1st. ReportCompletion AUG 27 1952RemarksGarvey - Contr.Spudding Date 7-13-52Drlg. Data Oil well TD 38938" @ 225 Anhy 878 Heeb. 3339Lans. 3479 Cong. 3773 Viola 3778Simp. 3831 Simp. sd. 3852 DST 3854-61open 1 hr. Rec. 305' free oil 60' ocm1475# Arb. 3887 DST 3888-93 open 1 hr.Rec. 30' mud 800# TD 3893 5" @ 38996/ 3852-53 S/ 3 boph 6/ 3853-54S/ 4 boph Comp. 94-bopd

J. G. McGEHEE