

Stafford

KANSAS

8

22


11W

SECTION \_\_\_\_\_ TOWNSHIP \_\_\_\_\_ RANGE \_\_\_\_\_

WELL NO. #3 Ericksen "B"

COMPANY Petroleum Inc.

NORTH N/2 NE SE

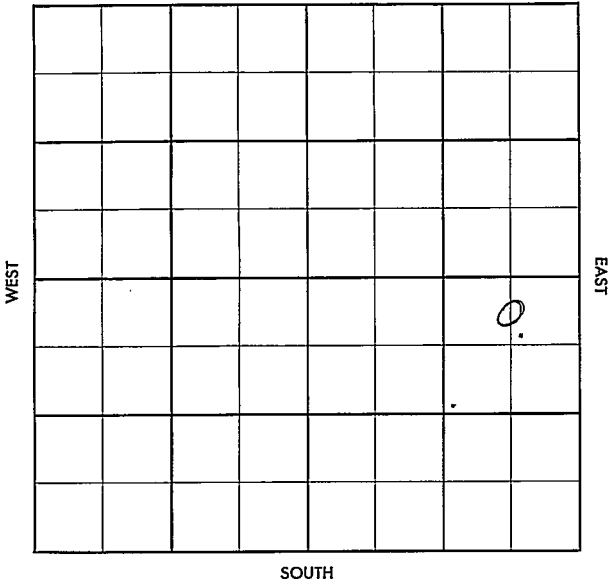

County Stafford Elev. \_\_\_\_\_  
 Sec. 8 Twp. 22 Rgs. 11W  
 Company Petroleum Inc.  
 Farm Name Ericksen "B" No. 3

TOPS	DEPTH	LOG	DATUM	Loc. in Sec.
Anh.	840			N/2 NE SE
Tp.				
H.				
Tr.				
Dg.				
Bl.				
L.				Geol. _____
K.C.				Contr. _____
B.K.C.				Garvey Tools
Ce.				
C.				Pool _____
M.				Shepherd NW
M.				
K.				
Mz.				
Ma.				
V.				
S.				
S.				FIRST REPORT
A.				
R.				
PE.				
G.				
T.D.				


Date Comm. 2-9-57  
8" @ 282 Delg. 1460

13

Co.  
Use.  
No.  
Sec.  
T.  
R.

County Stafford Elev. 1794  
 Sec. 8 Twp. 22 Rge. 11W  
 Company Petroleum Inc.  
 Farm Name Ericksen "B" No. 3

TOPS	DEPTH	LOG	DATUM	Loc. in Sec.
Anh.	840			N/2 NE SE
Tr.				
H.	3053			Geol.
Tr.	3070			
Dg.	3087			Contr.
Bl.	3190			
L.	3213			Pool
K.C.				
B.K.C.				Shepherd NW
Ce.				
C. <u>CHERT</u>	3494			ABANDONED
M. <u>C9 5d</u>	3507			
M.				FEB 27 '57
K.				
Mz.				
Mo.				
V.				
S.	3570			
S.				
A.				
R.				
PE.				
G.				
T.D.	3620			

Date Comm. 2-9-57

8" @ 282 Drilg. 1460 FEB 20 '57

DST 3222-65 1hr 120' GCM

BHP 400/20" DST 3264-92

1hr. 15' GCM BHP 0/20"

DST 3330-3430 1hr 154'

GCMW FP 200-300 BHP

1060/20" DST 3496-3520 1hr

150' WM FP 0-170 BHP 1040/20"

circ @ 3570 FEB 27 '57 DST 3569-76

FORM 513-1 SUNRAY

1hr rec 20' md BAY 800/20

DEA