


Section **8** Township **22** Range **11W**

Well No. **#1 Fair (A)**

Company **Palmer Oil**

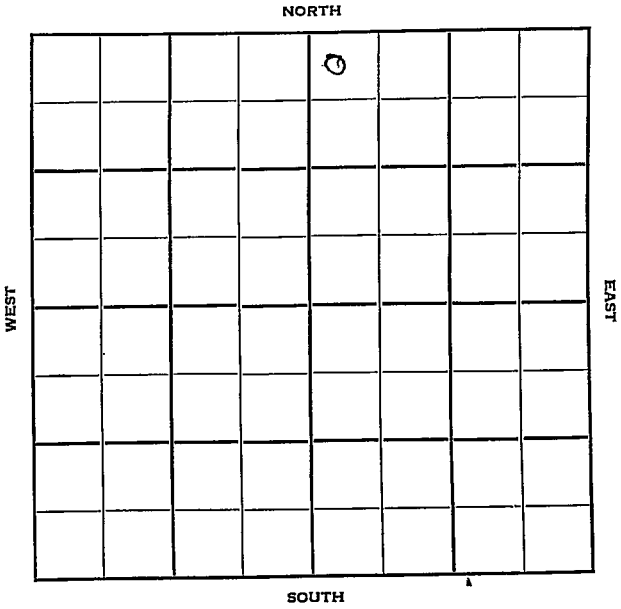

Sec. 8 Twp. 22 R. 11W

Well No. #1 Fair (A) Farm

Palmer Oil Company

" Wildcat Contractor


330 Ft. from N. Line

Ft. from S. Line

Ft. from E. Line

330 Ft. from W. Line

NW NW NE

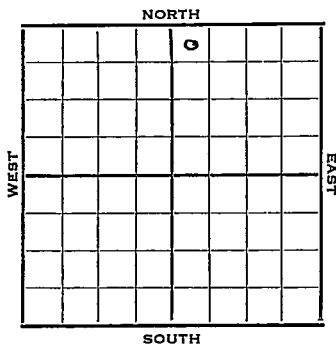

1952

Elev. 1775

REPORT

9/10 Cellar & Pits

9/17 8" @ 242'  
Heeb. 3039'  
Drlg. 3190'

9/24 Spud 9-7-52  
D&A TD 3605  
8" @242 Heeb. 3039 Br Lime 3173  
Lans. 3197  
DST 3466-3548 opn 3/4 hr. Rec. 135'  
g & ocm 185# Viola 3502  
Simp 3539 Arb. 3586 TD 3605  
D&A

**ABANDONED**

County Stafford State Kansas

Sec. 8 (Blk. Twp.) 22 (Sur. Rge.) 11W Map No.

Operator Palmer Oil

Well No. 1 Farm Fair (A)

Elev. \_\_\_\_\_ Location NW NW NE


FIRST REPORT

330 Ft. From N Line NE

330 Ft. From W Line Quarter

1st. Report SEP 10 1952

Completion \_\_\_\_\_

Remarks \_\_\_\_\_

Palmer Oil - Contr.

Spudding Date \_\_\_\_\_

Drlg. Data Wildcat

Cellar & pits

J. G. McGEHEE

County Stafford State Kansas

Sec. 8 (Blk. 22) (Sur. 11W) (Twp. 11W) Map No.

Operator Palmer Oil

Well No. 1 Farm Fair "A"

Elev. 1775 Location NW NW NE


330 Ft. From N Line NE

330 Ft. From W Line Quarter

1st. Report

Completion SEP 24 1952

Remarks Wildcat

Palmer - Contr.

Spudding Date 9-7-52

Drig. Data D & A TD 3605

8" @ 242 Heeb. 3039 Br. lime 3173

Lans. 3197 DST 3466-3548 open 3/4 hr.

Rec. 135' g & ocm 185# Viola 3502

Simp. 3539 Arb. 3586 TD 3605

D & A