
FORM 51 25M 8-50 WESTERN Stafford KANSAS

Section 8 Township 22 Range 12 W

Well No. #3 Charles

Company Atlantic

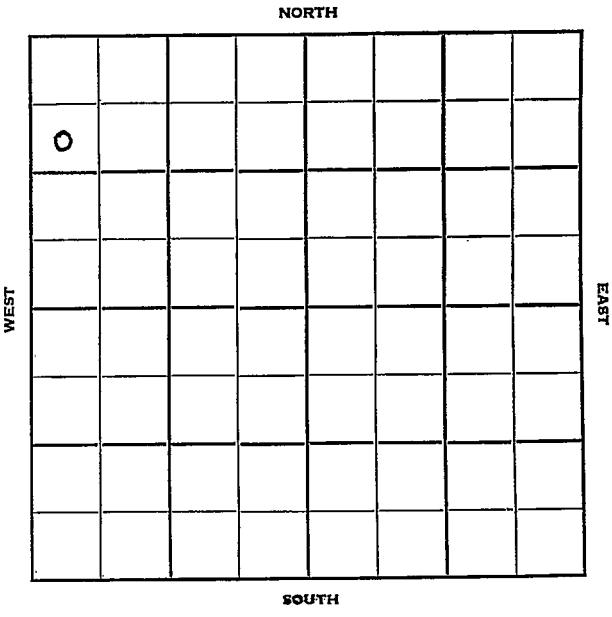

FORM 252-B
10M 10-50 PETROL

Stafford KANSAS

Sec. 8 Twp. 22 R. 12W

Well No. #3 Charles Farm

Atlantic Company

Holm Drlg. -Contr. Contractor

Drach Pool


990' Ft. from N. Line

Ft. from S. Line

Ft. from E. Line

330' Ft. from W. Line

SW NW NW

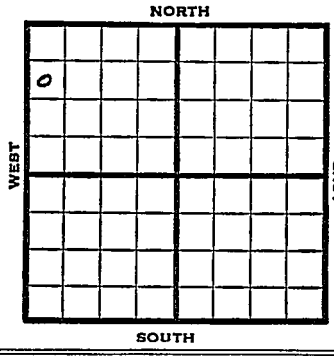

1951	Elev. 1872' REPORT
1/24	Spud 1-19-51 8" @ 268' Drlg. 2525'
2/28	Spud 1-19-51 Oil Well TD 3676 8" @ 268' Br Lime 3302 Lans. 3327 DST 3373-94 opn 1 hr Rec.30' mud Cong. 3564 Viola 3575 Simp. 3619 Arb. 3672-75 5" @ 3675 TD 3676 Comp. 80 bopd 2% wtr. COMPLETED

FORM 275 FOR SALE BY KANSAS BLUE PRINT CO.


County Stafford State Kansas

Sec. 8 (Blk. Twp.) 22 (Sur. Rge.) 12W Map No.

Operator Atlantic

Well No. 3 Farm Charles

Elev. 1872 Location SW NW NW

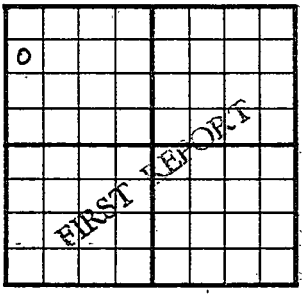

990 Ft. From N Line NW

330 Ft. From W Line Quarter

1st. Report JAN 24 1951

Completion

Remarks Holm Drlg. - Contr.

Spudding Date 1-19-51

Drlg. Data Drach Pool

8" @ 268 drlg. 2535

J. E. TYRA

FORM 275 FOR SALE BY KANSAS BLUE PRINT CO.


County Stafford State Kansas

Sec. 8 (Blk. Twp.) 22 (Sur. Rge.) 12W Map No.

Operator Atlantic

Well No. 3 Farm Charles

Elev. 1872 Location SW NW NW

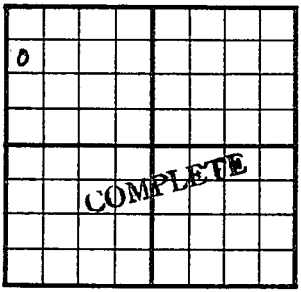

990 Ft. From N Line NW

330 Ft. From W Line Quarter

1st. Report

Completion FEB 28 1951

Remarks Drach Pool

Holm Drlg. - Contr.

Spudding Date 1-19-51

Drlg. Data Oil well TD 3676

8" @ 268 Br. lime 3302 Lans. 3327

DST 3373-94 open 1 hr. Rec. 30' mud

Cong. 3564 Viola 3575 Simp. 3619

Arb. 3672-75 5" @ 3675 TD 3676

Comp. 80 bopd 2% water

J. E. TYRA