


Section 8 Township 22<sup>N</sup> Range 12W

Well No. #2 Charles

Company Atlantic

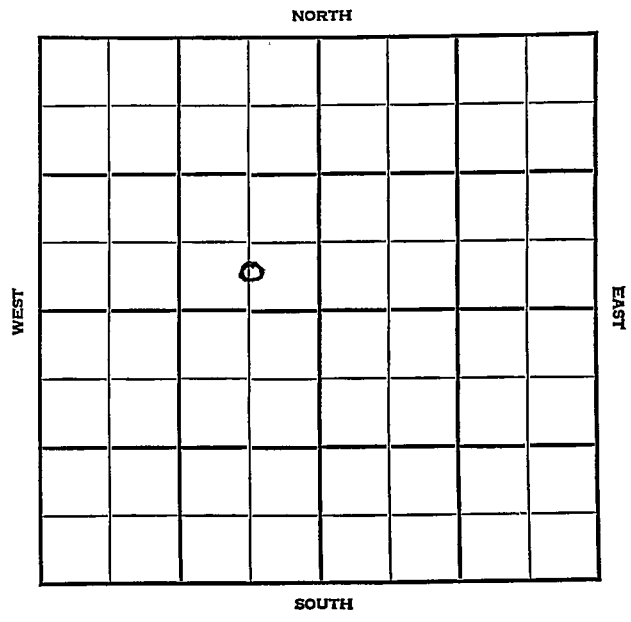

Sec. 8 Twp. 22 R. 12W

Well No. #2 Charles Farm

Atlantic Company

Brock Pool


\_\_\_\_\_ Ft. from N. Line

330' Ft. from S. Line

660' Ft. from E. Line

\_\_\_\_\_ Ft. from W. Line

C S L SE NW

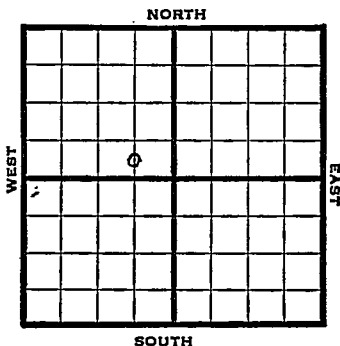

1948 Eli 1883' REPORT

- 6/9 Location
- 6/16 RUR
- 6/23 8" @ 282  
Dtg 300
- 6/29 Drlg 2490'
- 7/8 Lansing 3322'  
Viola 3579'  
Simpson 3620'  
Arb. 3680'  
TD 3685'  
5" @ 3682'
- 7/14 TD 3686'  
50 gal acid
- 7/21 1000 acid swb 10 bbls Oil PH
- 7/28 "
- 8/4 "
- 8/11 "
- 8/18 Arbuckle 3680'  
5" @ 3682'  
TD 3686'  
1000 acid  
Pump 591' oil pot  
40° Gr.  
Comp

**COMPLETED**

Map No. \_\_\_\_\_ Sec. 8 Twp. 22 R. 12W

Well No. 2 Charles

Atlantic Company

**FIRST REPORT**

Contractor

C S L SE NW

SECTION PLAT

\_\_\_\_\_ Ft. from N. Line

330 Ft. from S. Line

660 Ft. from E. Line

\_\_\_\_\_ Ft. from W. Line


Stafford County

Location X

Rig up \_\_\_\_\_

Drilling and Remarks: \_\_\_\_\_

RECORD

Cased \_\_\_\_\_ in., \_\_\_\_\_ ft.

Sand \_\_\_\_\_

Gas \_\_\_\_\_

Oil \_\_\_\_\_

Total Depth \_\_\_\_\_

PRODUCTION

1st 24 hrs. Nat. \_\_\_\_\_

1st 24 hrs. after shot \_\_\_\_\_

Gas \_\_\_\_\_ Cu. Ft.

Dry Hole \_\_\_\_\_

Abandoned \_\_\_\_\_

Date

JUN 9 1948

19

S. J. LEWIS

Scout

Stafford County Kansas State

Map No. 46 Sec. 8 Twp. 22 R. 12W

Well No. 2 Charles

Atlantic Company

COMPLETE

Contractor

C S L SE NW

*E. 11883*

SECTION PLAT


\_\_\_\_\_ Ft. from N. Line

330 Ft. from S. Line

660 Ft. from E. Line

\_\_\_\_\_ Ft. from W. Line

Broch Pool

Remarks:

*Cr 83680*

*5" @ 3682*

*NTJ 3686*

*1000000*

*Pump 591 oil Port*

*40 2/3*

Date

Scout

S. J. LEWIS

AUG 1 8 1948