KANSAS


FORM 51 5M BRIX

Stafford County

Section 8 Township 22 Range 12W

Well No. #1 Dohrman

Company Harsfield et al

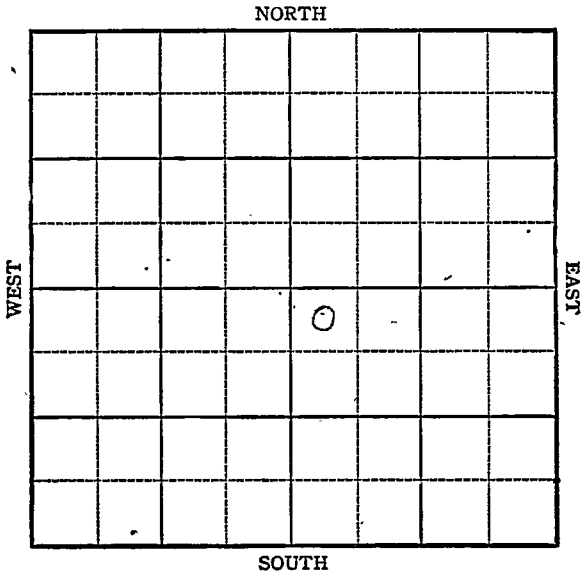

FORM 252-A
5M 9-44 PETROL

KANSAS

Stafford County

Sec. 8 Twp. 22 R. 12W

Well No. #1 Dohrman Farm

Harsfield et al Company

James


330 Ft. from N. Line

Ft. from S. Line

Ft. from E. Line

330 Ft. from W. Line

NW SE

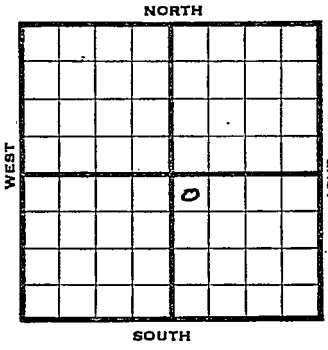

1944	REPORT
9/27	Location
10/4	10" @ 226 WOC
10/11	Drlg. 2050
10/18	Topeka 2904 Drlg. 3102
10/25	Lans 3322 Viola 3578 Drlg. 3614
11/1	Arb. 3678 TD 3689

ABANDONED

FORM 56 200 BKS. 4-44 PETROL

KANSAS

Pool Name James

Map No. 4 Sec. 8 Twp. 22 R. 12W

Well No. 1 Dohrman

Hersfield etal. Company

FIRST REPORT Contractor

NW SE


330 Ft. from N. Line

Ft. from S. Line

Ft. from E. Line

330 Ft. from W. Line

SECTION PLAT

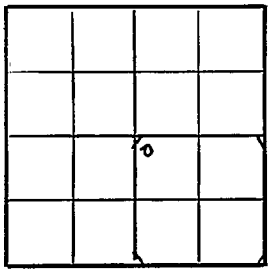

Stafford

Location X

Rig up

Drilling and Remarks:

RECORD

Cased in., ft.

Sand

Gas

Oil

Total Depth

PRODUCTION

1st 24 hrs. Nat.

1st 24 hrs. after shot

Gas Cu. Ft.

Dry Hole

Abandoned

Date

SEP 27 1944 19

S. J. LEWIS Scout

FORM 56 200 BKS, 1-44 PETROL

Pool Name James

Map No. 46 Sec. 8 Twp. 22 R. 12W


Well No. 1 Dohrman

Hersfield et al. Company

ABANDONED Contractor

NW SE

SECTION PLAT

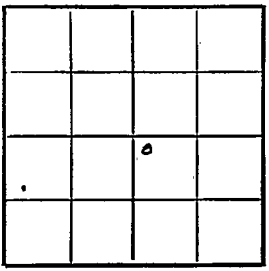

330 Ft. from N. Line

Ft. from S. Line

Ft. from E. Line

330 Ft. from W. Line

Stafford

Location

Rig up

Drilling and Remarks:

CP Y3678

RECORD

Cased in., ft.

Sand

Gas

Oil

Total Depth 3687

PRODUCTION

1st 24 hrs. Nat.

1st 24 hrs. after shot

Gas Cu. Ft.

Dry Hole

Abandoned

Date

NOV 1 1944 19

S. J. LEWIS Scout