


Stafford

KANSAS

Section 8 Township 22 Range 12WWell No. #4 CharlesCompany Atlantic

NORTH

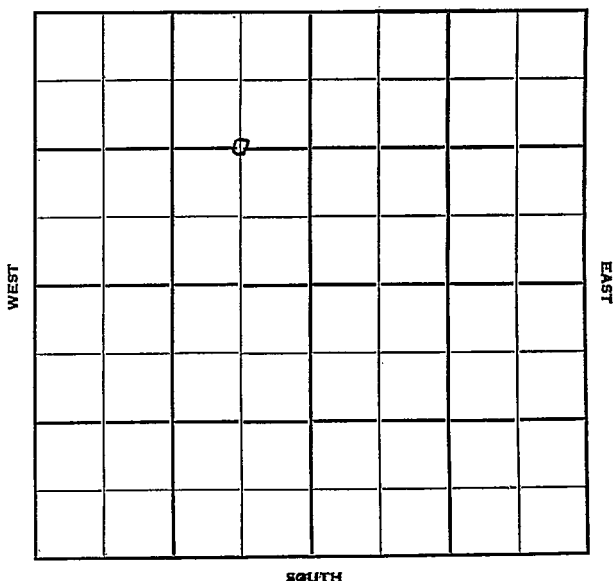

Stafford

KANSAS

Sec. 8 Twp. 22 R. 12 W ✓

Well No. # 4 Charles Farm

Atlantic

Company

Contractor

Drach


1270 Ft. from N. Line

Ft. from S. Line

660 Ft. from E. Line

Ft. from W. Line

C E $\frac{1}{2}$ NW

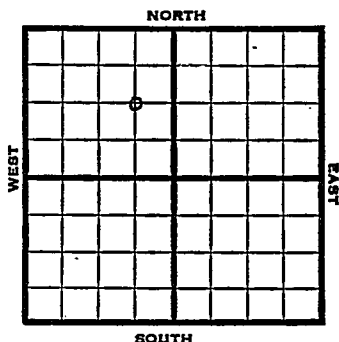

1951

Elev. 1876' REPORT

2/21


Spud 2-18-51
8" @297'

4/4

Spud 2-18-51
Oil Well TD 3677
8" @ 297
Heeb. 3172' Br Lime 3304
Lans. 3329' Cong. 3571'
Viola 3579 Simp 3617
Arb. 3671-74
5" @ 3674
TD 3677
Comp. 242 bopd

COMPLETED

County Stafford State Kansas
 Sec. 8 (Blk.) 22 (Sur.) 12W Map No.
 (Twp.)
 Operator Atlantic
 Well No. 4 Farm Charles
 Elev. Location C E $\frac{1}{2}$ NW

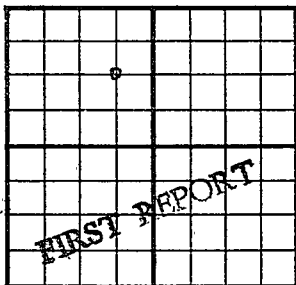

1270 Ft. From N Line NW
660 Ft. From E Line Quarter

1st. Report FEB 21 1951

Completion

Remarks


Spudding Date 2-18-51

Drlg. Data Drach Pool

8" @ 297

J. E. TYRA

County Stafford State Kansas
 Sec. 8 (Blk.) 22 (Sur.) 12W Map No.
 Operator Atlantic
 Well No. 4 Farm Charles
 Elev. 1876 Location C E $\frac{1}{2}$ NW

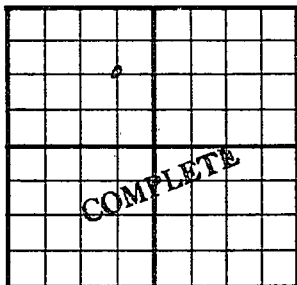

1270 Ft. From N Line NW
660 Ft. From E Line Quarter

Ist. Report

Completion APR 4 1951

Remarks Drach Pool

Spudding Date 2-18-51

Drilg. Data Oil well TD 3677

8" @ 297 Heeb. 3172 Br. lime 3304

Lans. 3329 Cong. 3571 Viola 3579

Simp. 3617 Arb. 3671-74 5" @ 3674

TD 3677 Comp. 242 bopd