



Harvey

Map No. KANSAS Sec. 8 Twp 22 R. 3W

Well No. 3-Andrews Farm


Texas Company

330 Ft. from N. Line

\_\_\_\_\_ Ft. from S. Line

\_\_\_\_\_ Ft. from E. Line

330 Ft. from W. Line

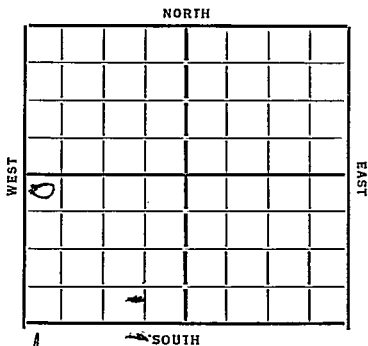

Special

Date	REPORT
1933	
9/27	Bldg Rig
10/11	12' at 284 10reg 891
10/18	10reg 2225
10/25	K.C.H 2500 - 10reg 2768
11/1	T.D. 2953 Lost circulation
11/8	Top chat 3156 - T.D. 3176
	8' at 3171 N.M.S.T.
11/15	—
11/22	Fish bailer
11/29	Show oil 3185 10reg 3212
12/6	Base Miss 3325
	Top Hunton 3425
	10reg 3454
12/13	Uicla 3582 Wilcox 3685 T.D. 3618
	Too water plug back to Hunton
12/27	Plug back to 3478 - shot
	40 gts - treated with 1000
	gal acid - pump 75 bbls
	24 hrs
(1934)	
1/3	Wilcox 3605-3618 T.D. P.B. to 3478 Hunton Line
	1000 gal acid Pump 75 bbls
	COMPLETED

Map No. 43 Sec. 8 Twp. 27 R. 3W

Well No. 3 Andrews

Texas Co Company

Contractor

# SPECIAL

## SECTION PLAT

330 Ft. from N. Line

..... Ft. from S. Line

..... Ft. from E. Line

330 Ft. from W. Line

o			

# FIRST REPORTS

Location.....

Rig up.....

Drilling and Remarks:

BR

# SPECIAL RECORD

Cased          in.,          ft.

Sand.....

Gas.....

Oil.....

Total Depth.....

## PRODUCTION

1st 24 hrs. Nat.....

1st 24 hrs. after shot.....

Gas..... Cu. Ft.

Dry Hole.....

Abandoned.....

Date

SEP 27 1933

C. Manschuff Scout

Map No. 430 Sec. 8 Twp. 22 R. 3W

Well No. 3-Andrews

Texas Co

Company

Contractor

SECTION PLAT

330 Ft. from N. Line

..... Ft. from S. Line

..... Ft. from E. Line

330 Ft. from W. Line

0			

**COMPLETED**

Location.....

Rig up.....

Drilling and Remarks:

*plug back*  
*3478-Huntline*  
*1000 gal acid*  
*pump 75 lbs*

RECORD

Cased..... in., ..... ft.

Sand *Wilcox 3605*

Gas.....

Oil.....

Total Depth 3618

PRODUCTION

1st 24 hrs. Nat.....

1st 24 hrs. after shot.....

Gas..... Cu. Ft.

Dry Hole.....

Abandoned.....

Date

1-3-34 192 O. Manschreck Scout