


Narvey

Map No. **KANSAS** Sec. 8 Twp. 22 R. 3W

Well No. 4 Andrews Farm
Texas Co. Company

990 Ft. from N. Line
 Ft. from S. Line
 Ft. from E. Line
330 Ft. from W. Line

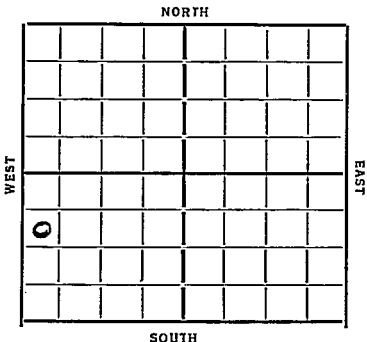

Date
1934

REPORT

3/21 Bldg. Rot Rig
3/29 12" 308 710C
4/5 _____
4/12 Dlg 2664 K.C. 2485
4/19 " 3190 Chst 3145
4/26 8" 3185 S.O. 3190-92 Rust
5/3 Dlg 3197
5/10 " 3278
5/18 Hutton 3430 6" 3432
5/25 TV 3572 Wilcox 3589
PB 3465
5/31 TD 3465 shot 20 gts
Cement 6"
6/7 _____
6/14 3465 TD 1000 acid No results
6/21 CO to reacidize
6/28 _____ 7/5 _____ 7/12 _____
7/18 Hutton 3430 Viola 3572
Wilcox 3589 PB 3465
acidized 2 times 8 oil 12 water

COMPLETED

KANSAS

Map No. 43 Sec. 8 Twp. 22 R. 3W

Well No. 4 Andrews

Texas Co Company

Contractor

SECTION PLAT

FIRST REPORTS

990 Ft. from N. Line

..... Ft. from S. Line

..... Ft. from E. Line

330 Ft. from W. Line

Location.....

Rig up.....

Drilling and Remarks:

Beag Pot Rig

RECORD

Cased..... in., ft.

Sand.....

Gas.....

Oil.....

Total Depth.....

PRODUCTION

1st 24 hrs. Nat. 37180

1st 24 hrs. after shot 507

Gas..... Cu. Ft.

Dry Hole.....

Abandoned.....

Date

3/21-34 192

O. Mannschreck Scout

KANSAS

Map No. 430 Sec. 8 Twp. 22 R. 3W

Well No. H-Andrews

Texas Co Company

Contractor

~~WARRANTED~~

SECTION PLAT

0			

990 Ft. from N. Line

_____ Ft. from S. Line

_____ Ft. from E. Line

330 Ft. from W. Line

Location _____

Rig up _____

Drilling and Remarks:

*Plug back
to 3465
acidized two
times.
8 oil
12 water*

RECORD

Cased _____ in., _____ ft.
~~Sand~~ *Huntow 3430*
~~Gas~~ *Viola 3572*
~~Oil~~ *Wilcox 3589*
 Total Depth _____

PRODUCTION

1st 24 hrs. Nat. _____
 1st 24 hrs. after shot _____
 Gas _____ Cu. Ft.
 Dry Hole _____
 Abandoned _____

Date

7-18-34 19____

ORVAL MANNSCHRECK

Scout