


Section 8 Township 22 Range 3-W

Well Number #3 Dyck

Company Boviard Supply et al

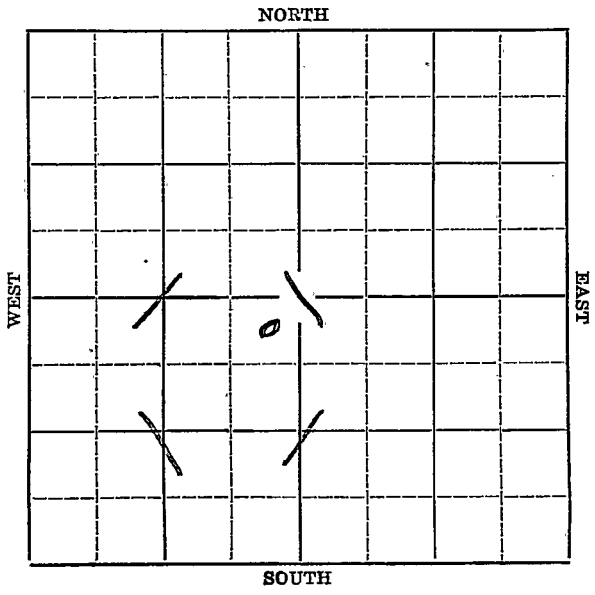



**KANSAS**

Map No. 43 Sec. 8 Twp. 22 R. 3W.

Well No. 3 Truck

Borward Supply & Co. Company  
Contractor

**SECTION PLAT**


330 Ft. from N. Line

\_\_\_\_\_ Ft. from S. Line

330 Ft. from E. Line

\_\_\_\_\_ Ft. from W. Line

**FIRST REPORT**

Location \_\_\_\_\_

Rig up \_\_\_\_\_

Drilling and Remarks:

12 1/2' @ 358

In 191068

Borward Supply  
has taken over

this 40 acres

**RECORD**

Cased \_\_\_\_\_ in., \_\_\_\_\_ ft.

Sand \_\_\_\_\_

Gas \_\_\_\_\_

Oil \_\_\_\_\_

Total Depth \_\_\_\_\_

**PRODUCTION**

1st 24 hrs. Nat. \_\_\_\_\_

1st 24 hrs. after shot \_\_\_\_\_

Gas \_\_\_\_\_ Cu. Ft.

Dry Hole \_\_\_\_\_

Abandoned \_\_\_\_\_

Date

NOV 4 1936

S. J. LEWIS Scout

# KANSAS

Map No. T 43 Sec. 8 Twp. 22 R. 3W.

Well No. 3 Tyck

Bonard Supply & Co. Company

Contractor

## SECTION PLAT

	o		

230 Ft. from N. Line

\_\_\_\_\_ Ft. from S. Line

330 Ft. from E. Line

\_\_\_\_\_ Ft. from W. Line

**COMPLETED**

Location \_\_\_\_\_

Rig up \_\_\_\_\_

Drilling and Remarks:

Hutton 3496

2000 acid

28649

## RECORD

Cased \_\_\_\_\_ in., \_\_\_\_\_ ft.

Sand \_\_\_\_\_

Gas \_\_\_\_\_

Oil \_\_\_\_\_

Total Depth 3535

## PRODUCTION

1st 24 hrs. Nat. \_\_\_\_\_

1st 24 hrs. after shot \_\_\_\_\_

Gas \_\_\_\_\_ Cu. Ft.

Dry Hole \_\_\_\_\_

Abandoned \_\_\_\_\_

Date

DEC 16 1936 19

S. J. LEWIS Scout