

Harvey


Form 51-5M-11-31-Palace

Map No. KANSAS Sec. 8 Twp. 22 R. 3W

Well No. 1 - J. Neufedt Farm

Shell Pet Company

NORTH

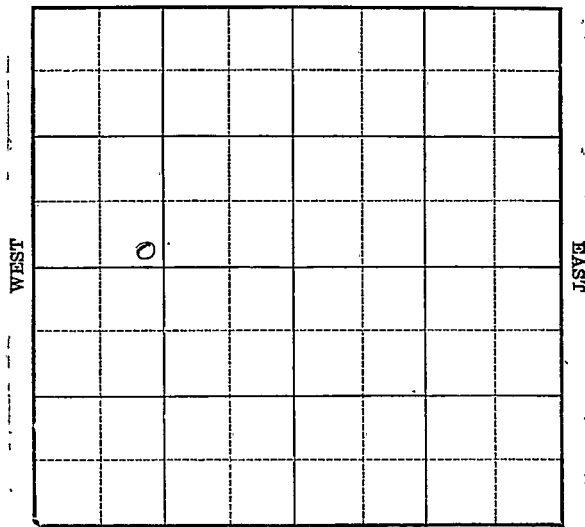

SOUTH

OWNED

Location _____

Drilling Remarks _____

RECORD

Cased _____ in. _____ ft.

Sand _____

Gas _____

Oil _____

Total Depth _____

Rig Up _____

Drilling Remarks _____

PRODUCTION

1st 24 hrs. Nat. _____

1st 24 hrs. after shot _____

Gas _____ cu. ft. _____

Dry Hole _____

Abandoned _____

Harvey

Map No. KANSAS Sec. 8 Twp 22 R. 3W


Well No. #1 J. Neufeldt Farm
Shell Pet Company

_____ Ft. from N. Line

330 Ft. from S. Line

_____ Ft. from E. Line

990 Ft. from W. Line

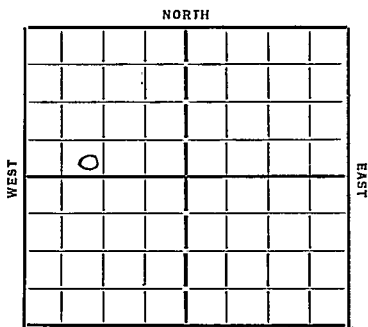

Special OCU(11)

Date 1933

REPORT

- 9/13 Cellar
- 9/20 Rgn up
- 9/29 13" 336. Hreg 1390
- 10/5 dly 2878'
- 10/11 T. Chat 3166 - Hreg 3198
- 10/18 8" at 3184 - T.D 3206 - 1M gas and spray oil
- 10/25 Flow 335 bbls 13 hrs.
- 11/1 T.D. 3207. pump 88 bbls in 11 hrs. 30% B.S.
- 11/8 no test
- 11/15 — 11/22 — 11/29 — 12/6 —
- 12/13 — 12/27 —

1934

1/10 Chat 3166 T.D. 3207
59 Bbls Oil 85 lbs Water

COMPLETED

- 1934 OCU(11)
- 10/21 Rgn to deepen
- 11/7 dly 3261
- 11/15 30503 fcy
- 11/29 698 30520

— OVER —

11/28 7" 3320 A.L. 3335
57 3376

12/6 Alg 3427 7" 3404

12/13 Misener 3443

Huntou 3447

7" 3444 ~~to~~ WOC

12/21 Base Huntou 3475

T 7 3484

1000 acid

P 197 Bbls 14 hrs.

12/26 Huntou 3447

T 7 3484

1000 acid

249 Bbls.

COMPLETED

Map No. 430 Sec. 8 Twp 22 R. 3W

Well No. #1- J. Neufeldt

Shell pet Company

Contractor

SPECIAL

SECTION PLAT

..... Ft. from N. Line

330 Ft. from S. Line

..... Ft. from E. Line

990 Ft. from W. Line

	o		

FIRST REPORTS

Location.....

Rig up.....

Drilling and Remarks:

cellar

RECORD

Cased..... in., ft.

Sand.....

Gas.....

Oil.....

Total Depth.....

PRODUCTION

1st 24 hrs. Nat.....

1st 24 hrs. after shot.....

Gas..... Cu. Ft.

Dry Hole.....

Abandoned.....

Date

9/13/33 192 O. Mannschel Scout

Map No. 43 Sec. 8 Twp. 22 R. 3W

Well No. 1 - Menard

Shell pet. Company

Contractor

SECTION PLAT

..... Ft. from N. Line

330 Ft. from S. Line

..... Ft. from E. Line

990 Ft. from W. Line

COMPLETED

0			
"			

RECORD

Location.....

Cased..... in., ft.

Rig up.....

Sand Chat 3166

Drilling and Remarks:

Gas.....

Oil.....

Total Depth 3207

PRODUCTION

1st 24 hrs. Nat.....

1st 24 hrs. after shot.....

Gas..... Cu. Ft.

Dry Hole.....

Abandoned.....

59 oil
85 water

Date

1-10-34 192 O. Mammisch Scout

WALSAS

Map No. 43 Sec. 8 Twp. 22 R. 3W

Well No. 1-9. Neufeldt

Shell pet Company

Contractor

FIRST REPORTS

SECTION PLAT

_____ Ft. from N. Line

330 Ft. from S. Line

_____ Ft. from E. Line

990 Ft. from W. Line

OWP N

Location _____

Rig up _____

Drilling and Remarks:

OTD 3207

Rign up to
deeper

RECORD

Cased _____ in., _____ ft.

Sand _____

Gas _____

Oil _____

Total Depth _____

PRODUCTION

1st 24 hrs. Nat. _____

1st 24 hrs. after shot _____

Gas _____ Cu. Ft.

Dry Hole _____

Abandoned _____

Date

10-31-34 19

ORVAL MANNSCHECK

Scout

Map No. 43 Sec. 8 Twp. 22 R. 3W

Well No. 1 - J. Neufeldt
Shell pet Company

Contractor

COMPLETED

SECTION PLAT

.....Ft. from N. Line

330 Ft. from S. Line

.....Ft. from E. Line

990 Ft. from W. Line

OWP 11

Location.....

Rig up.....

Drilling and Remarks:

1000 acid

249 bbls

RECORD

Cased.....in.,ft.

Sand Hutton 3447

Gas.....

Oil.....

Total Depth 3484

PRODUCTION

1st 24 hrs. Nat.....

1st 24 hrs. after shot.....

Gas.....Cu. Ft.

Dry Hole.....

Abandoned.....

Date

ORVAL MANNSCHRECK

12-26-34 192

Scout