


Section 8 Township 22 Range 3-W

Well Number 4 Newfeldt *(Newfeldt)*

Company Shell

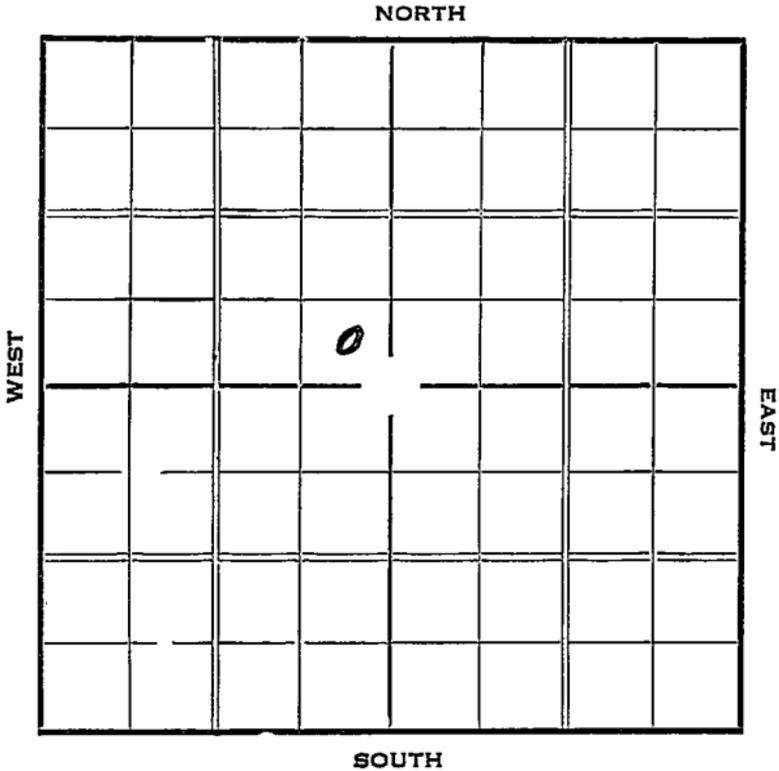

**KANSAS**

Harvey

Map No. .... Sec. 8 ..... Twp. 22 ..... R. 3W .....

Well No. 4 Newfeldt ..... Farm

..... Shell ..... Company


..... Ft. from N. Line

330 Ft. from S. Line

440 Ft. from E. Line

..... Ft. from W. Line

*Elev. 1456*

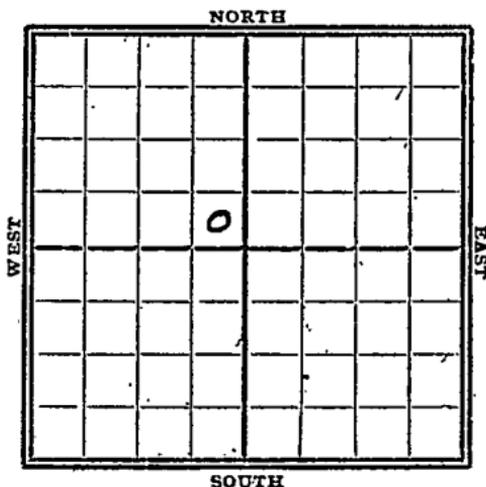

Date	REPORT
1936	
12-9	Rigging up
12/17	12" @ 334'. Drlg. 690'.
12/24	Drlg. 2081'.
12/29	Drlg. 2490'.
1937	
1/7	Chat 3159'. Drlg. 3179'.
1/14	7" @ 3432'. Misner 3486'.
	Hunton 3487' Drlg.
1/22	T. D. 3493 fishing liner.
1/28	Drlg. 3496'.
2/4	T. D. 3534'. 800' oil in holw.
2/11	1000 acid Pump 254 Oil 9 hrs.
2/17	Hunton 3487'.
	T. D. 3534'.
	1000 acid.
	Potential 488.
<u>COMPLETED</u>	

# KANSAS

Map No. 43 Sec. 5 Twp. 22 R. 3 W.

Well No. 4 Neufeldt

Shell Company

Contractor

### SECTION PLAT

	0		

\_\_\_\_\_ Ft. from N. Line

330 Ft. from S. Line

440 Ft. from E. Line

\_\_\_\_\_ Ft. from W. Line

### FIRST REPORT

Location \_\_\_\_\_

Rig up \_\_\_\_\_

Drilling and Remarks:

*Rigging up.*  
*SJL*

### RECORD

Cased \_\_\_\_\_ in., \_\_\_\_\_ ft.

Sand \_\_\_\_\_

Gas \_\_\_\_\_

Oil \_\_\_\_\_

Total Depth \_\_\_\_\_

### PRODUCTION

1st 24 hrs. Nat. \_\_\_\_\_

1st 24 hrs. after shot \_\_\_\_\_

Gas \_\_\_\_\_ Cu. Ft.

Dry Hole \_\_\_\_\_

Abandoned \_\_\_\_\_

Date

DEC 9 1935 19

S. J. LEWIS Scout

# KANSAS

Map No. 43 Sec. 8 Twp. 22 R. 3W

Well No. 4 Newfieldt

Shell Company

Contractor

### SECTION PLAT


\_\_\_\_\_ Ft. from N. Line

330 Ft. from S. Line

440 Ft. from E. Line

\_\_\_\_\_ Ft. from W. Line

## COMPLETED

Location \_\_\_\_\_

Rig up \_\_\_\_\_

Drilling and Remarks:

*Hutton 3487.*

*1000 acid*

*Potential 488*

### RECORD

Cased \_\_\_\_\_ in., \_\_\_\_\_ ft.

Sand \_\_\_\_\_

Gas \_\_\_\_\_

Oil \_\_\_\_\_

Total Depth 3534

### PRODUCTION

1st 24 hrs. Nat. \_\_\_\_\_

1st 24 hrs. after shot \_\_\_\_\_

Gas \_\_\_\_\_ Cu. Ft.

Dry Hole \_\_\_\_\_

Abandoned \_\_\_\_\_

Date

FEB 17 1937

19

S. J. LEWIS

Scout