

Harvey

Map No. KANSAS Sec. 8 Twp. 22 R. 3W


Well No. 1-Nickel Farm
mabee-shell Company

_____ Ft. from N. Line

330 Ft. from S. Line

_____ Ft. from E. Line

330 Ft. from W. Line

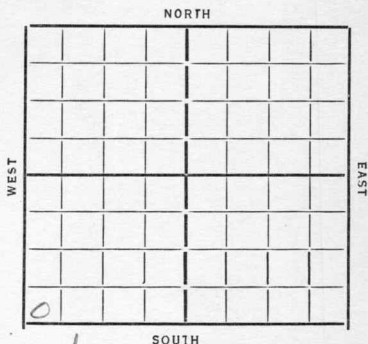

Special

Date
1933

REPORT

10/11 Rig Rotary
10/18 15" at 470 - w.o.c.
10/25 wreg 1900
11/1 " 30.55
11/8 Top Chat 3130 - T.D. 3200
11/15 Hunter 3395
Viola 3544 set 7"
11/22 RUST
11/29 Wilcox 3560
oil 3560-65 T.D. 3570
swab 110 bbls 5 hrs
shot 10 gts
12/6 wedging pipe at 2753
12/13 Moringen Rotary
12/27 _____
1/11 T.D. 3571 - run 5"
1/17 _____ 1/24 e.o.
1/31 _____
2/7 shot 10 gts Est 25 Bbls per hr.
2/14 Wilcox 3560 TD 3572 977 Bbls!

COMPLETED

Map No. 43 Sec. 8 Twp. 22 R. 3N

Well No. 1- Nubbel

Mahee & Shell Company

Contractor

FIRST REPORTS

SECTION PLAT

..... Ft. from N. Line

330 Ft. from S. Line

..... Ft. from E. Line

330 Ft. from W. Line

SPECIAL

Location.....

Rig up.....

Drilling and Remarks:

Rig out

RECORD

Cased.....in.,ft.

Sand.....

Gas.....

Oil.....

Total Depth.....

PRODUCTION

1st 24 hrs. Nat.....

1st 24 hrs. after shot.....

Gas.....Cu. Ft.

Dry Hole.....

Abandoned.....

Date

10-11-33 192 O. Manschud Scout

Map No. 43 Sec. 8 Twp. 22 R. 3W

Well No. 1- Mikkil

Mabe + Shell Company

Contractor

COMPLETED

SECTION PLAT

0			

.....Ft. from N. Line

330 Ft. from S. Line

.....Ft. from E. Line

330 Ft. from W. Line

RECORD

Location.....

Cased.....in.,ft.

Rig up.....

Sand Wiley of 3560

Drilling and Remarks:

Gas.....

Oil.....

Total Depth 3572

947 bbls

PRODUCTION

1st 24 hrs. Nat.....

1st 24 hrs. after shot.....

Gas..... Cu. Ft.

Dry Hole.....

Abandoned.....

Date

2-14-34 192 O. Mannschrack Scout