

Harvey

KANSAS

SECTION 8 TOWNSHIP 22S RANGE 3W

WELL NO. #1 Schmidt


COMPANY Ray Law & Jack Speer S/2 NWSW

NORTH

~~N/2 SW SW~~

WEST

EAST

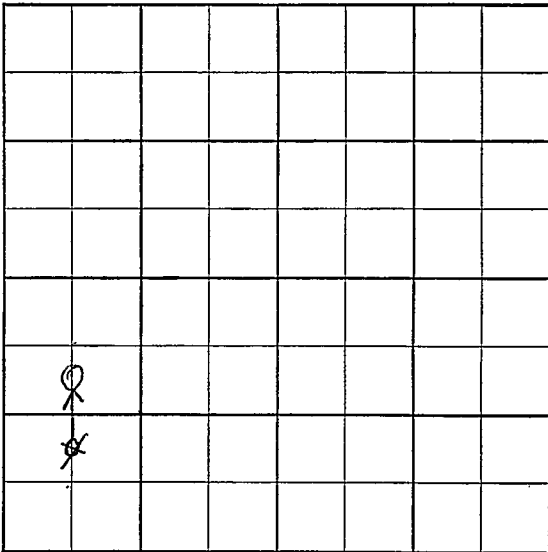

SOUTH

S-513-B

~~Top~~ ~~Post~~ ~~Co.~~ ~~Face~~

County Harvey Elev. _____
 Sec. 8 Twp. 22 Rge. 3W
 Company Ray Law & Jack Speer
 Farm Name Schmidt No. 1

TOPS	DEPTH	LOG	DATUM
Anh.			
Tp.			
H.			
Tr.			
Dg.			
B.L.			
L.			
K.C.			
B.K.C.			
Ce.			
C.			
M.			
M.			
K.			
Mz.			
Mq.			
V.			
S.			
S.			
A.			
R.			
Pf.			
G.			
T.D.			

Loc. in Sec. N/2 SW SW


Geol. _____

Contr. _____

Melland Drlg.

Pool _____

Hollow-Nickel

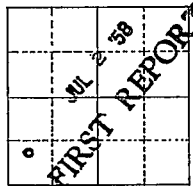

Date Comm. 6-28-58
8" @ 316 Drlg. 1110

Co.

Lse.

No.

Sec.

T.

R.

Twp. 2 Pool X

CORRECTION
Co. A Facet X

S-513-B

County Harvey Elev 14' 1/2" 17' 1/2" 18'
Sec. 8 Twp. 22 Rge. 3W
Company Ray Law & Jack Speer
Farm Name Schmidt No. 1

TOPS	DEPTH	LOG	DATUM
Anh.			
Tp.			
H.			
Tr.			
Dg.			
B.L.			
L.			
K.C.			
B.K.C.			
Ge.			
C.			
M.	<u>3148</u>		
M. <u>Hunt</u>	<u>3434</u>		
K.			
Mz.			
Mq.			
V.			
S.			
S.			
A.			
R.			
Pf.			
G.			
T.D.	<u>3442</u>		

Loc. in Sec. N/2 SW SW
1/2 NW SW

Geol. _____
Contr. _____
Melland Drile
Pool _____
Hollow-Nickel

COMPLETE
AUG 6 '58

Date Comm. 6-28-58
BH @ 316 Drile. 1110 JUL 9 '58 5" 3438/50
JUL 16 '58 CO DD 3463 10g oph NW
14" 1" 1/2" 1/2" DD 3467 TD
JUL 23 '58 JUL 30 '58 PB 3466 POP
AUG 6 '58 ~~P4 Bopd~~ P4 Bopd
+ 50% AW and silt

4