


Section 8 Township 22 Range 8-W

Well Number 1 Balder-Siemans

Company Shell

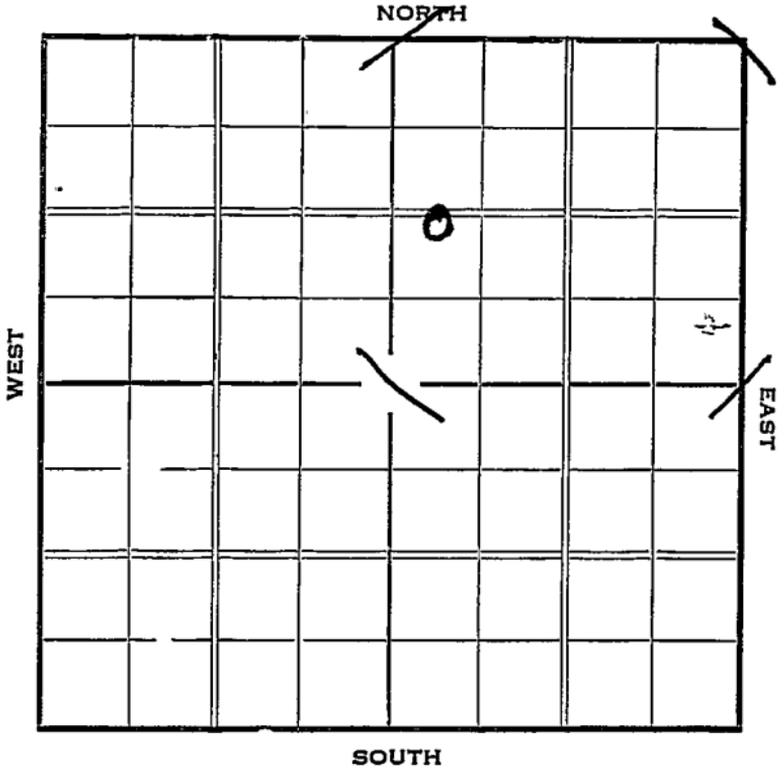

1937

3/31

Hunton 3522'.

T. D. 3558'.

Shot 30 qts.

3000 acid.

Potential 15 oil, 30 water.

COMPLETED

KANSAS

Map No. J 49 Sec. 5 Twp. 22 RSW

Well No. Baldwin-Simons

Shell. Company

Contractor

SECTION PLAT

		0	

 Ft. from N. Line

1302 Ft. from S. Line

 Ft. from E. Line

330 Ft. from W. Line

FIRST REPORT

Location

Rig up

Drilling and Remarks:

July 1520

RECORD

Cased in., ft.

Sand

Gas

Oil

Total Depth

PRODUCTION

1st 24 hrs. Nat.

1st 24 hrs. after shot

Gas Cu. Ft.

Dry Hole

Abandoned

Date

DEC 22 1931 19

S. J. LEWIS Scout

Harvey

Map No. _____ Sec. 8 Twp. 22 R. 3W

Well No. 1 Balder Siemens

Shell Company

Contractor

CORRECTION

SECTION PLAT

_____ Ft. from N. Line

1302 Ft. from S. Line

_____ Ft. from E. Line

330 Ft. from W. Line

		o	

Location _____

RECORD

Rig up _____

Drilling and Remarks:

Cased _____ in., _____ ft.

Sand _____

Gas _____

Oil _____

Total Depth _____

PRODUCTION

1st 24 hrs. Nat. _____

1st 24 hrs. after shot _____

Gas _____ Cu. Ft.

Dry Hole _____

Abandoned _____

**Correct
RANGE FROM
8W TO 3W**

Date

Dec 22 1936

S. J. LEWIS Scout

Washaw
2 #1 sheet
cells in
lb - 160 acres

Ray

Returned

Cards

Tracing

France Map

Scarborough Map

Moody Map

Scarborough Plat Book

Moody Plat Book

For
BENT
W

KANSAS *Harvey*

Map No. _____ Sec. 8 Twp. 22 R. 3W

Well No. 1 *Baldwin Siemens*

Shell Company

Contractor

SECTION PLAT

		EL 1456	

_____ Ft. from N. Line

1302 Ft. from S. Line

_____ Ft. from E. Line

330 Ft. from W. Line

COMPLETED

Location _____

Rig up _____

Drilling and Remarks:

Hutton 3522.

*Shot 309 to
3000 acid*

*Potential
15 oil
80 water*

RECORD

Cased _____ in., _____ ft.

Sand _____

Gas _____

Oil _____

Total Depth 3558

PRODUCTION

1st 24 hrs. Nat. _____

1st 24 hrs. after shot _____

Gas _____ Cu. Ft.:

Dry Hole _____

Abandoned _____

Date

MAR 31 1937

S. J. LEWIS Scout

Check Range we show no well located
at this spot. Advise

Sam

no well here

Paul

Returned	_____
Cards	_____ <i>Paul</i>
Tracing	_____
France Map	_____
Scarborough Map	_____
Moody Map	_____
Scarborough Plat Book	_____
Moody Plat Book	_____

We show a Number one shell
well located NW NE



We show a number one shell
well located SW NE

We show this well also in NE Q
Check and advise if all three
wells are O.K. and located in the
NE Quarter Sam

The plat shows the way we are
carrying these wells



	01 shell
	01 shell
	01 shell

Returned
Cards
Tracing
France Map
Scarborough Map
Moody Map
Scarborough Plat Book
Moody Plat Book

Form *ks.*-2-29

Harvey.

Sec. *8* Twp. *22* R. *3W*

Well No. *1 Balder-Siemens*

Shell Company

Contractor

SECTION PLAT

		0	

* _____ Ft. from N. Line

1302 Ft. from S. Line

_____ Ft. from E. Line

330 Ft. from W. Line

COMPLETED

Location _____

Rig up _____

Drilling and Remarks:

Hutton 3522.

*Shot 309 lb
3000 acid*

*Potential 15 oil
30 water*

over

RECORD

Cased _____ in., _____ ft.

Sand _____

Gas _____

Oil _____

Total Depth *3558*

PRODUCTION

1st 24 hrs. Nat. _____

1st 24 hrs. after shot _____

Gas _____ Cu. Ft.

Dry Hole _____

Abandoned _____

Date

APR 21 1937 19

S. J. LEWIS

Scout

This NE quarter is two Leases
north & south. They. C. L. Luman had
the two Leases and drilled the
well and called it number one
The other wells in this quarter are
numbered right & three number
one's in this quarter. Lewis

RAY

Returned	<i>Paul</i>
Cards	<i>Paul</i>
Tracing	<i>Paul</i>
France Map	<i>Paul</i>
Scarborough Map	<i>Paul</i>
Moody Map	<i>Paul</i>
Scarborough Plat Book	<i>Paul</i>
Moody Plat Book	<i>Paul</i>