


Harvey
3/20

Map No. KANSAS Sec. 8 Twp. 22 R. 3

Well No. 1- Siemens Farm
Shell Pet Company

330 Ft. from N. Line
 Ft. from S. Line
 Ft. from E. Line
330 Ft. from W. Line

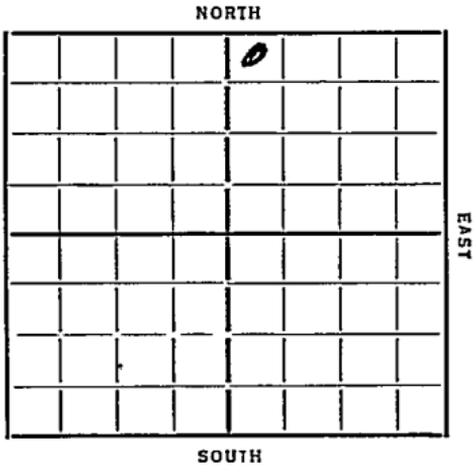

Elev. 1458

Date	REPORT
7/7	Location
7/14	dyg 596 13" 336
7/18	" 2547 KC 2530
7/26	" 3281 Chat 3174
8/1	Nuntow 3504 7" 3505
	Situation 3506-08
8/8	3511 220 Core 3511-14" 22
	1" 2" set
8/15	BH. 3525 T 7 3538
	2000' Oil 1000 acid
	p. 100 Bbls 7 hrs.
8/22	237 Bbls 24 hrs.
8/29	Shot 100 70 pts Co.
19/6	—
9/20	Nuntow 3504
	T 7 3525
	393 Bbls.
	COMPLETED

Map No. 43 Sec. 8 Twp. 22 R. 3W

Well No. 1 - Siemens

Shell pat Company

Contractor

FIRST REPORTS

SECTION PLAT

330 Ft. from N. Line

..... Ft. from S. Line

..... Ft. from E. Line

330 Ft. from W. Line

		0	

Location

Rig up

Drilling and Remarks:

RECORD

Cased.....in.,ft.

Sand.....

Gas.....

Oil.....

Total Depth.....

PRODUCTION

1st 24 hrs. Nat.....

1st 24 hrs. after shot.....

Gas.....Cu. Ft.

Dry Hole.....

Abandoned.....

Date

7-2-35

192.....

ORVAL MANNING

Scout

Map No. 243 Sec. 8 Twp. 27 R. 3W

Well No. 1 - Siemens

Shell pet Company

Contractor

COMPLETED

SECTION PLAT

		0	

330 Ft. from N. Line

..... Ft. from S. Line

..... Ft. from E. Line

330 Ft. from W. Line

Location.....

Rig up.....

Drilling and Remarks:

393
ffts

RECORD

Cased..... in., ft.

Sand Hunter 3504

Gas.....

Oil.....

Total Depth 3525

PRODUCTION

1st:24 hrs. Nat.....

1st 24 hrs. after shot.....

Gas..... Cu. Ft.

Dry Hole.....

Abandoned.....

Date

9-20-35

ORVAL MANNSCHRECK

Scout