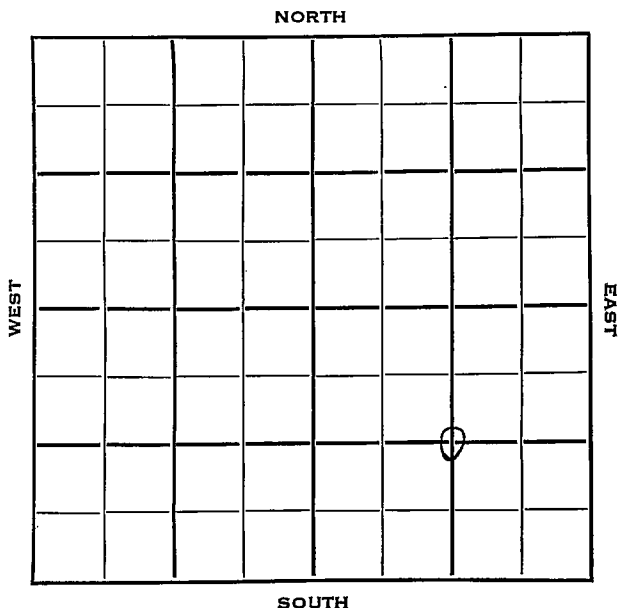


Section 8 Township 22 Range 35 WWell No. # 1 CampbellCompany Walter Kuhn et al

Kearny

KANSAS

SEC.	TWP.	R.
8	22	35W ✓

WELL NO.

#1 Campbell

FARM

COMPANY

Walter Kuhn et al

CONTRACTOR


Hugoton Pool

_____ Ft. from N. Line

1320 _____ Ft. from S. Line

1320 _____ Ft. from E. Line

_____ Ft. from W. Line

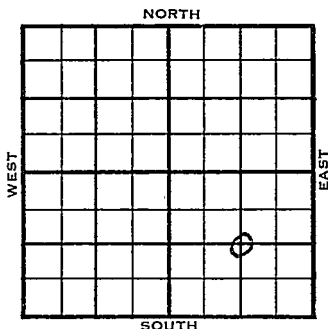


C SE/4


Carter F/O

	ELEVATION	REPORT
1953	=	
11/30	Spud 11-29-53 Drlg.	
12/9	10" @ 205' w/175 sks Drlg. 1720'	
12/16	Drlg 2420'	
1954 1/6	Spud 11-29-53 Gas Well TD 2645' 10" @ 205' Her. 2607' TD 2670' 7" @ 2602' DD 2645' Kri. 2643' 500 A frac. Comp 4½ mcf/gpd 405#	

COMPLETED

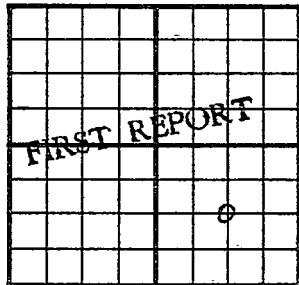County Hearny State KansasSec. 8 (Blk.) 22 (Sur.) 35W (Twp.) Map No.Operator Walter Kuhn et al.Well No. 1 Farm CampbellElev. Location C SE/41320 Ft. From S Line SE1320 Ft. From E Line Quarter1st. Report DEC 2 1953CompletionRemarks Carter farmoutSpudding Date 11-29-53Drlg. Data Hugoton Pooldrlg.

J. G. McGEHEE

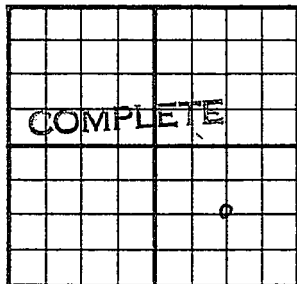County Kearny State KansasSec. 8 (Blk.) 22 (Sur.) 35W Map No.Operator Walter Kuhn et al.Well No. 1 Farm CampbellElev. Location C SE/41320 Ft. From S Line SE1320 Ft. From E Line Quarter1st. ReportCompletion JAN 6 1954Remarks Hugoton PoolSpudding Date 11-29-53Drlg. Data Gas well TD 264510" @ 205 Her. 2607 TD 26707" @ 2602 DD 2645 Kri. 2643 500 Afrac Comp. $4\frac{1}{2}$ mcf/gpd 405#