


Stafford

KANSAS

SECTION 9 TOWNSHIP 22 RANGE 13W

WELL NO. #1 Pieper

COMPANY Term. Gas Trans.

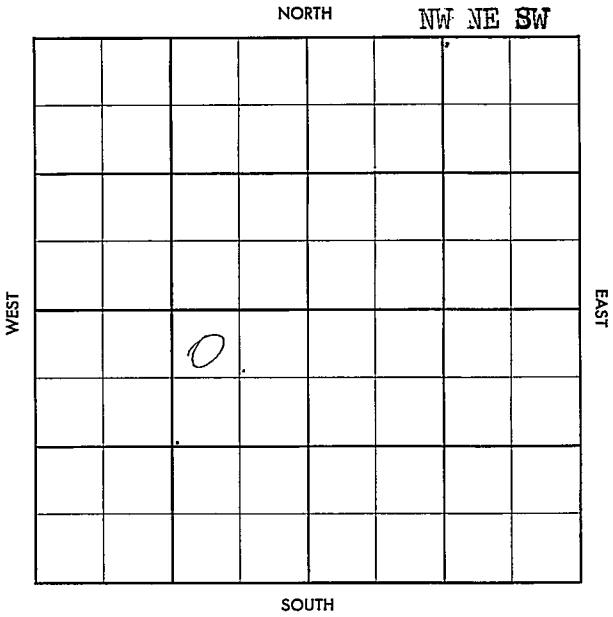



County Stanford Elev. 1898  
 Sec. 9 Twp. 22 Rge. 13W  
 Company Tenn. Gas. Trans.  
 Farm Name Pieper No. 1

TOPS	DEPTH	LOG	DATUM	Loc. in Sec.
Anb.				NW NE SW.
TP.				
H.	3249			
Tr.	3269			
Dg.				
Bl.	3377			
L.	3396			
K.C.				Geol.
B.K.C.	3618			Contr.
Ce.				Strata Drlg.
C. <u>cherty</u>	3672			
M.				Pool
M.				Silver Bell.
K.				
Mz.				
Ma.				
V.	3695			<div style="border: 1px solid black; padding: 5px; text-align: center;"> <b>ABANDONED</b>            MAY 1 57         </div>
S.	3738			
S.				
A.	3793			
R.				
PE.				
G.				
TD.	3830			

Date Comm. 4-17-57

8" @ 391/225, Drlg. 3285 MAY 1 57

DST 3514-50 1hr rec 900'

MSW BHP 805/20" DST 3550

-3600 1hr 100' WM BHP 980

/20" DST 3645-90 30" rec 10'

Md BHP 70/20" DST 3665-3710

1hr rec 25' Md BHP 60/20"

DST 3735-80 45" rec 10' Md

BHP 0 DE/2